


**Application Map**

**City of Aumsville**


Application #:                      Permit #:

KEY TO STREET PREFIX

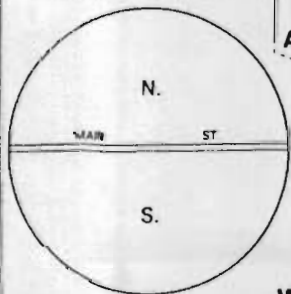

Well located 2400' N & 1000' E from SW corner Section 30.

- OPENED HIGHWAY
- STREET OPEN FOR TRAVEL
- CITY LIMITS
- INTERSTATE ROUTE
- U.S. ROUTE
- STATE ROUTE
- TERMINATION OF FA SYSTEM
- PUBLIC BUILDING
- COURT HOUSE
- CITY HALL
- ARMORY
- POST OFFICE
- SCHOOL
- LIBRARY

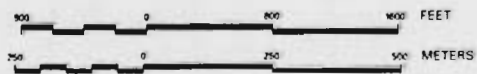

PREPARED BY THE  
OREGON DEPARTMENT OF TRANSPORTATION  
IN COOPERATION WITH THE  
U.S. DEPARTMENT OF TRANSPORTATION  
FEDERAL HIGHWAY ADMINISTRATION  
COPIES AVAILABLE AT NOMINAL COST FROM:  
OREGON DEPT. OF TRANSPORTATION  
PHOTOCOPY & MAP DISTRIBUTION UNIT  
TRANSPORTATION BLDG. ROOM 17  
SALEM, OREGON 97309



**AUMSVILLE**

MARION COUNTY  
T. 8 S. R. 1-2 W. W.M.  
Population 1500

FEBRUARY 1989

Application No. G-14758  
Permit No. G-13679

**RECEIVED**

MAY 26 1998

WATER RESOURCES DEPT.  
SALEM, OREGON