

This map was prepared for assessment purpose only.

SECTION 5 T.4S. R.1E. W.M.
CLACKAMAS COUNTY

D.L.C.
LUCIUS A. SEELY NO. 48
SAMUEL K. BARLOW NO. 50

4 IE 5
& INDEX

RECEIVED


APR - 8 1998

WATER RESOURCES DEPT.
SALEM, OREGON

1" = 400'

- Cancelled Tax Lots
- 402
 - 400A2
 - 400A1
 - 202
 - 203
 - 205

Application # G-14779
Permit no # G-13684

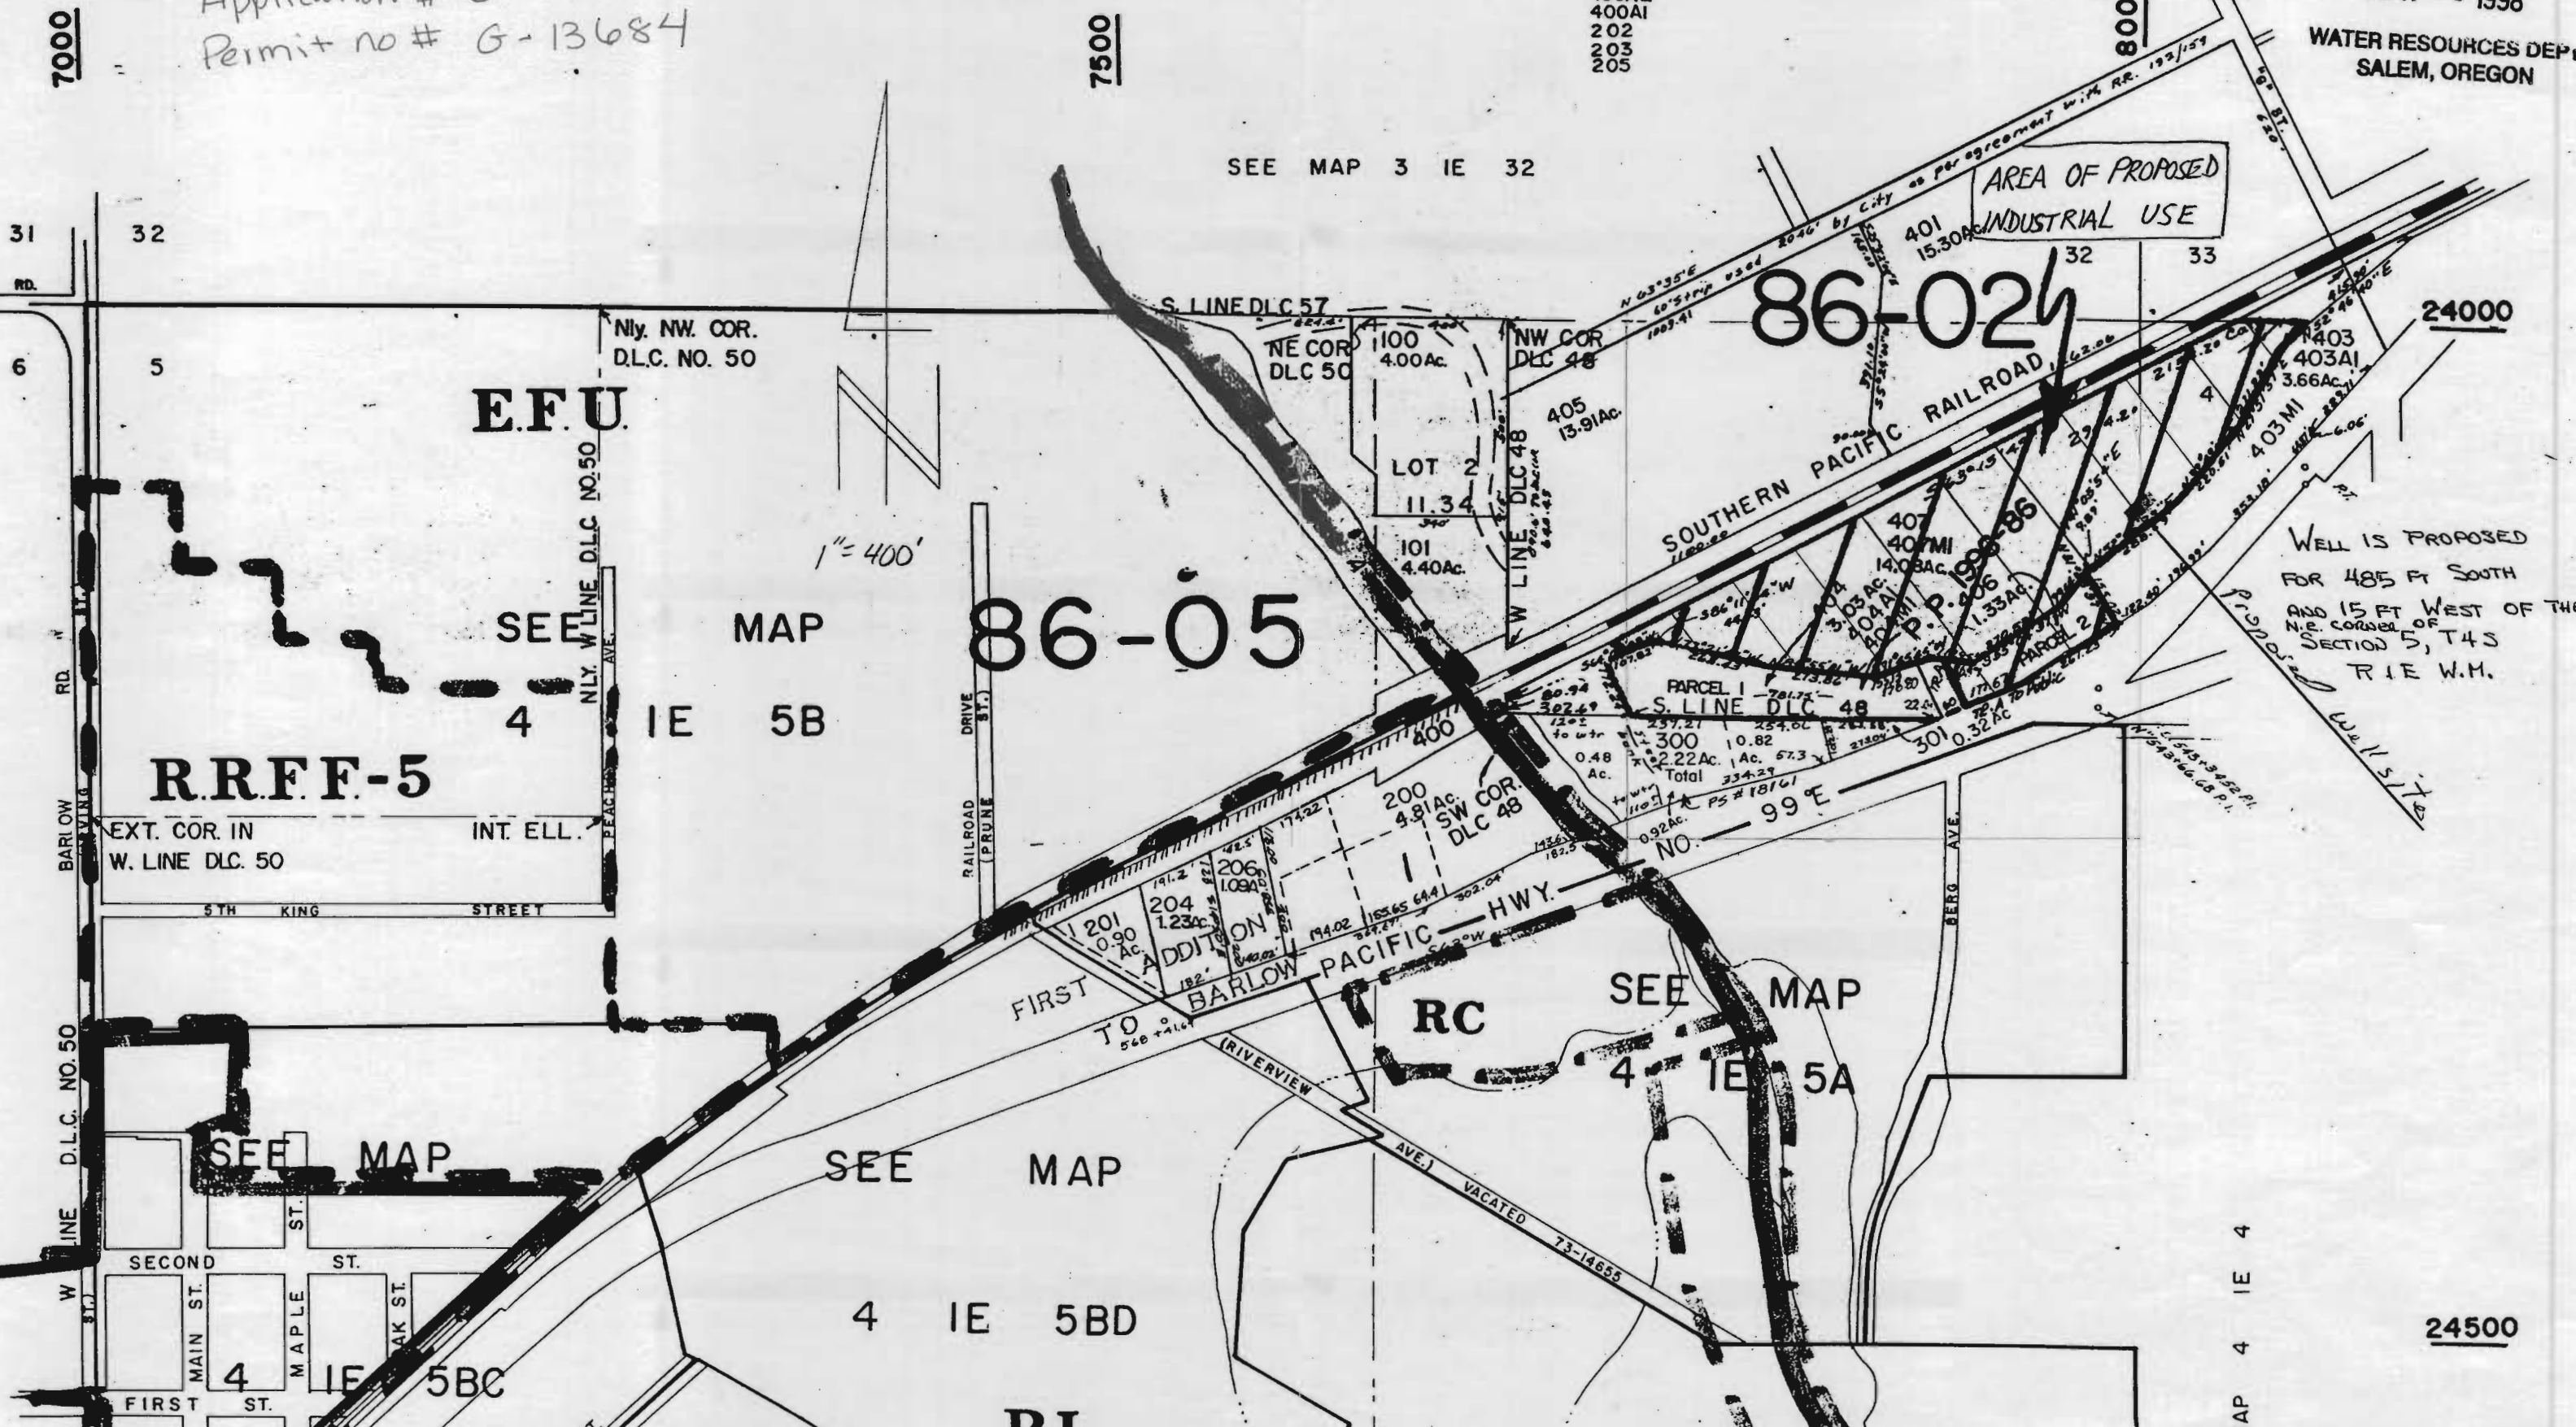

E.F.U.

86-024

86-05

R.R.F.F.-5

RC

24500

MAP 4 IE 4

RT