



T.5S., R.1W., W.M

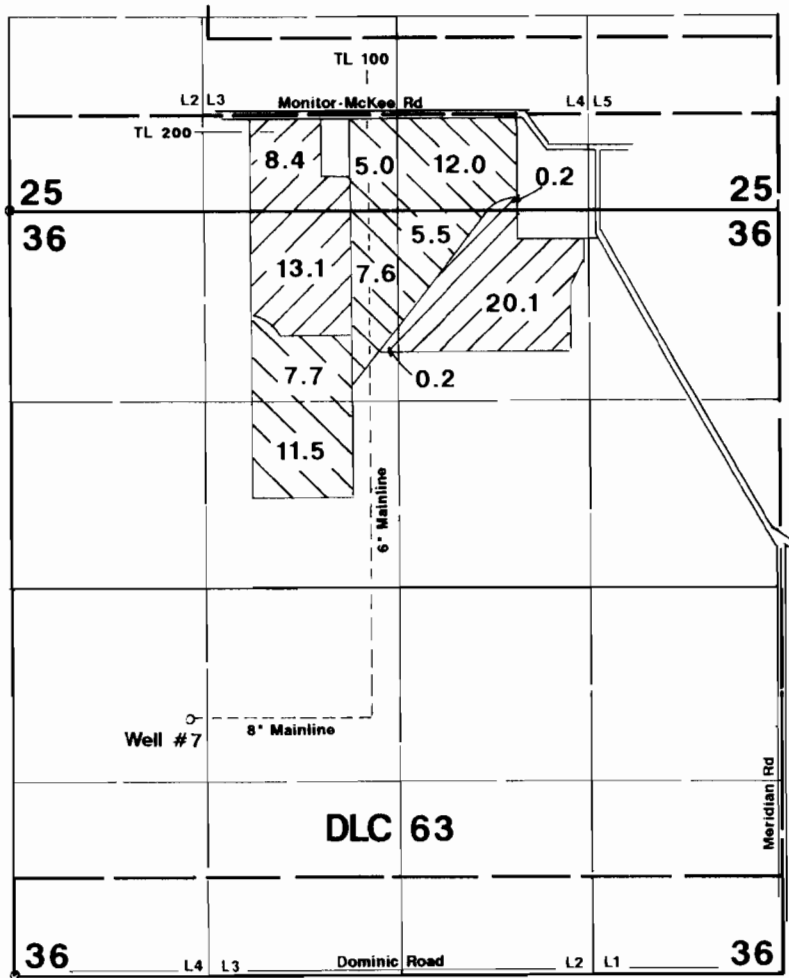

1" = 1320'

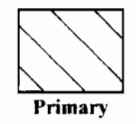

Area Irrigated

Well #7 is located 1700'N & 1220'E from the SW corner of Section 36.

RECEIVED

**WATER RESOURCES DIV
SALEM OREGON**

Final Proof Survey

In Name Of

James Butsch

Application #: G-14807 Permit #: G-13700

Surveyed on September 3, 2004 by JM Schuette

This Map Was Prepared For The Purpose Of Identifying The Location Of A Water Right Only And Is Not Intended To Provide Legal Dimensions Or Location Of Property Ownership Lines

