


SEC.34 T3S R1W WM, MARION COUNTY

3 1W 34

CLACKAMAS COUNTY

Cancelled
400
500
1200

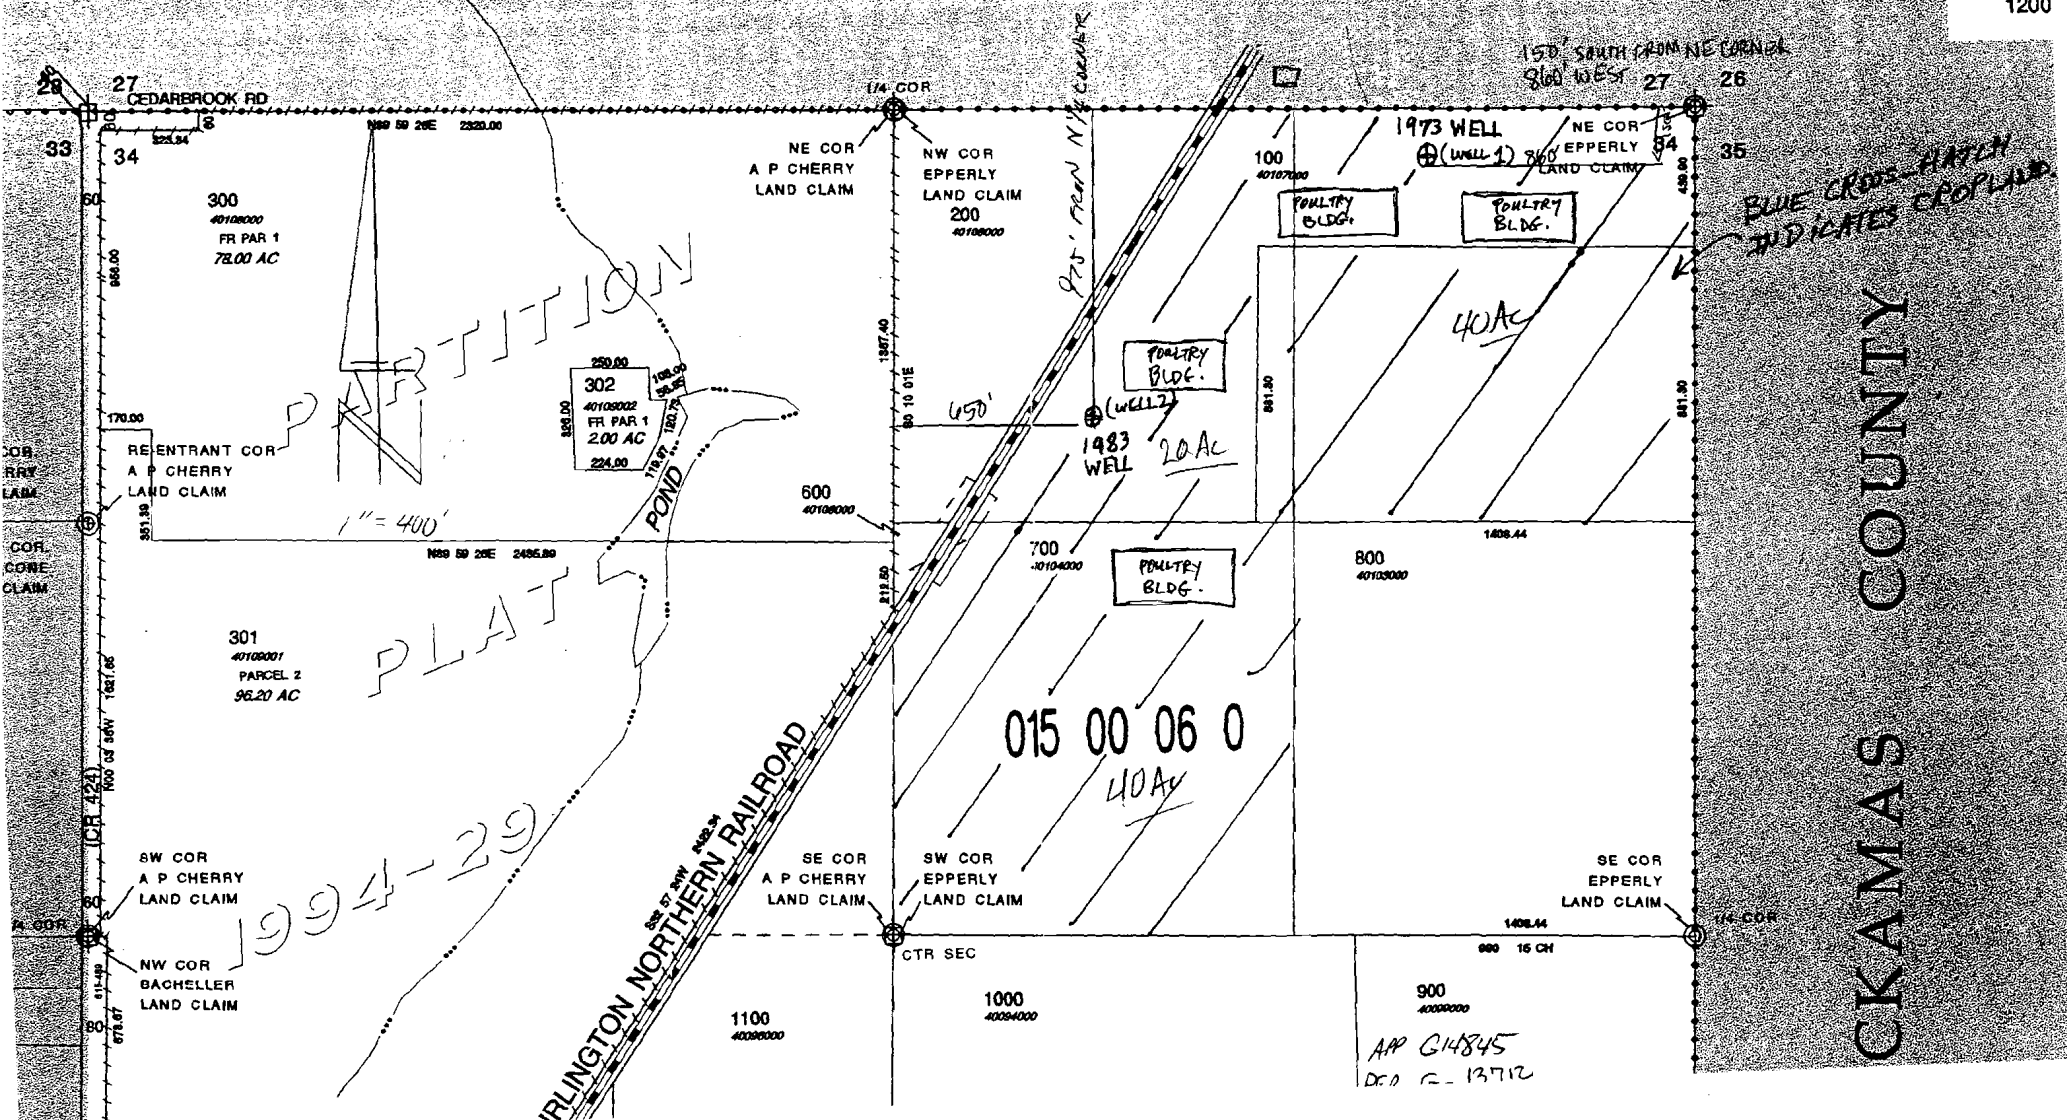

BLUE CROSS-HATCH INDICATES CROPLAND

CLACKAMAS COUNTY

N 89 58 45W 1284.05

APP G14845
DEC 13 1972