


T. 9 S. R. 1 W. W. M.

RECEIVED

JUL 10 1998

WATER RESOURCES DEPT
SALEM, OREGON

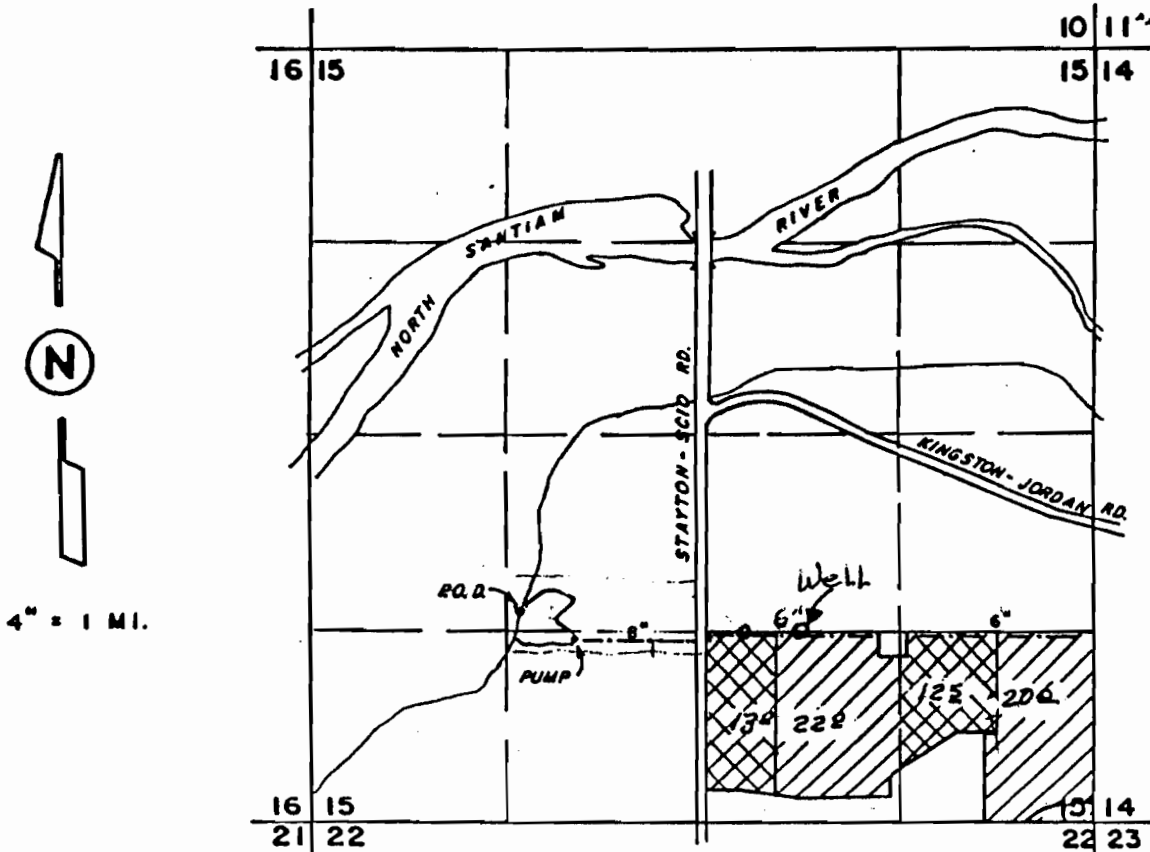

New Well: 1310' N + 560' E. of S¹/₄ Cor Sec 15

Tax Lot No. 1900

WATER RIGHT MAP FOR

JCK Leasing LLC.

Application No. 014803
Permit No. G-13720