

Application No. G-14888

Permit No. G-13730


1" = 660'

Sheet 1 of 2

SECTION PLAT

Section 33 Township 22-S Range 32 1/2-E

County of Harney State of OREGON

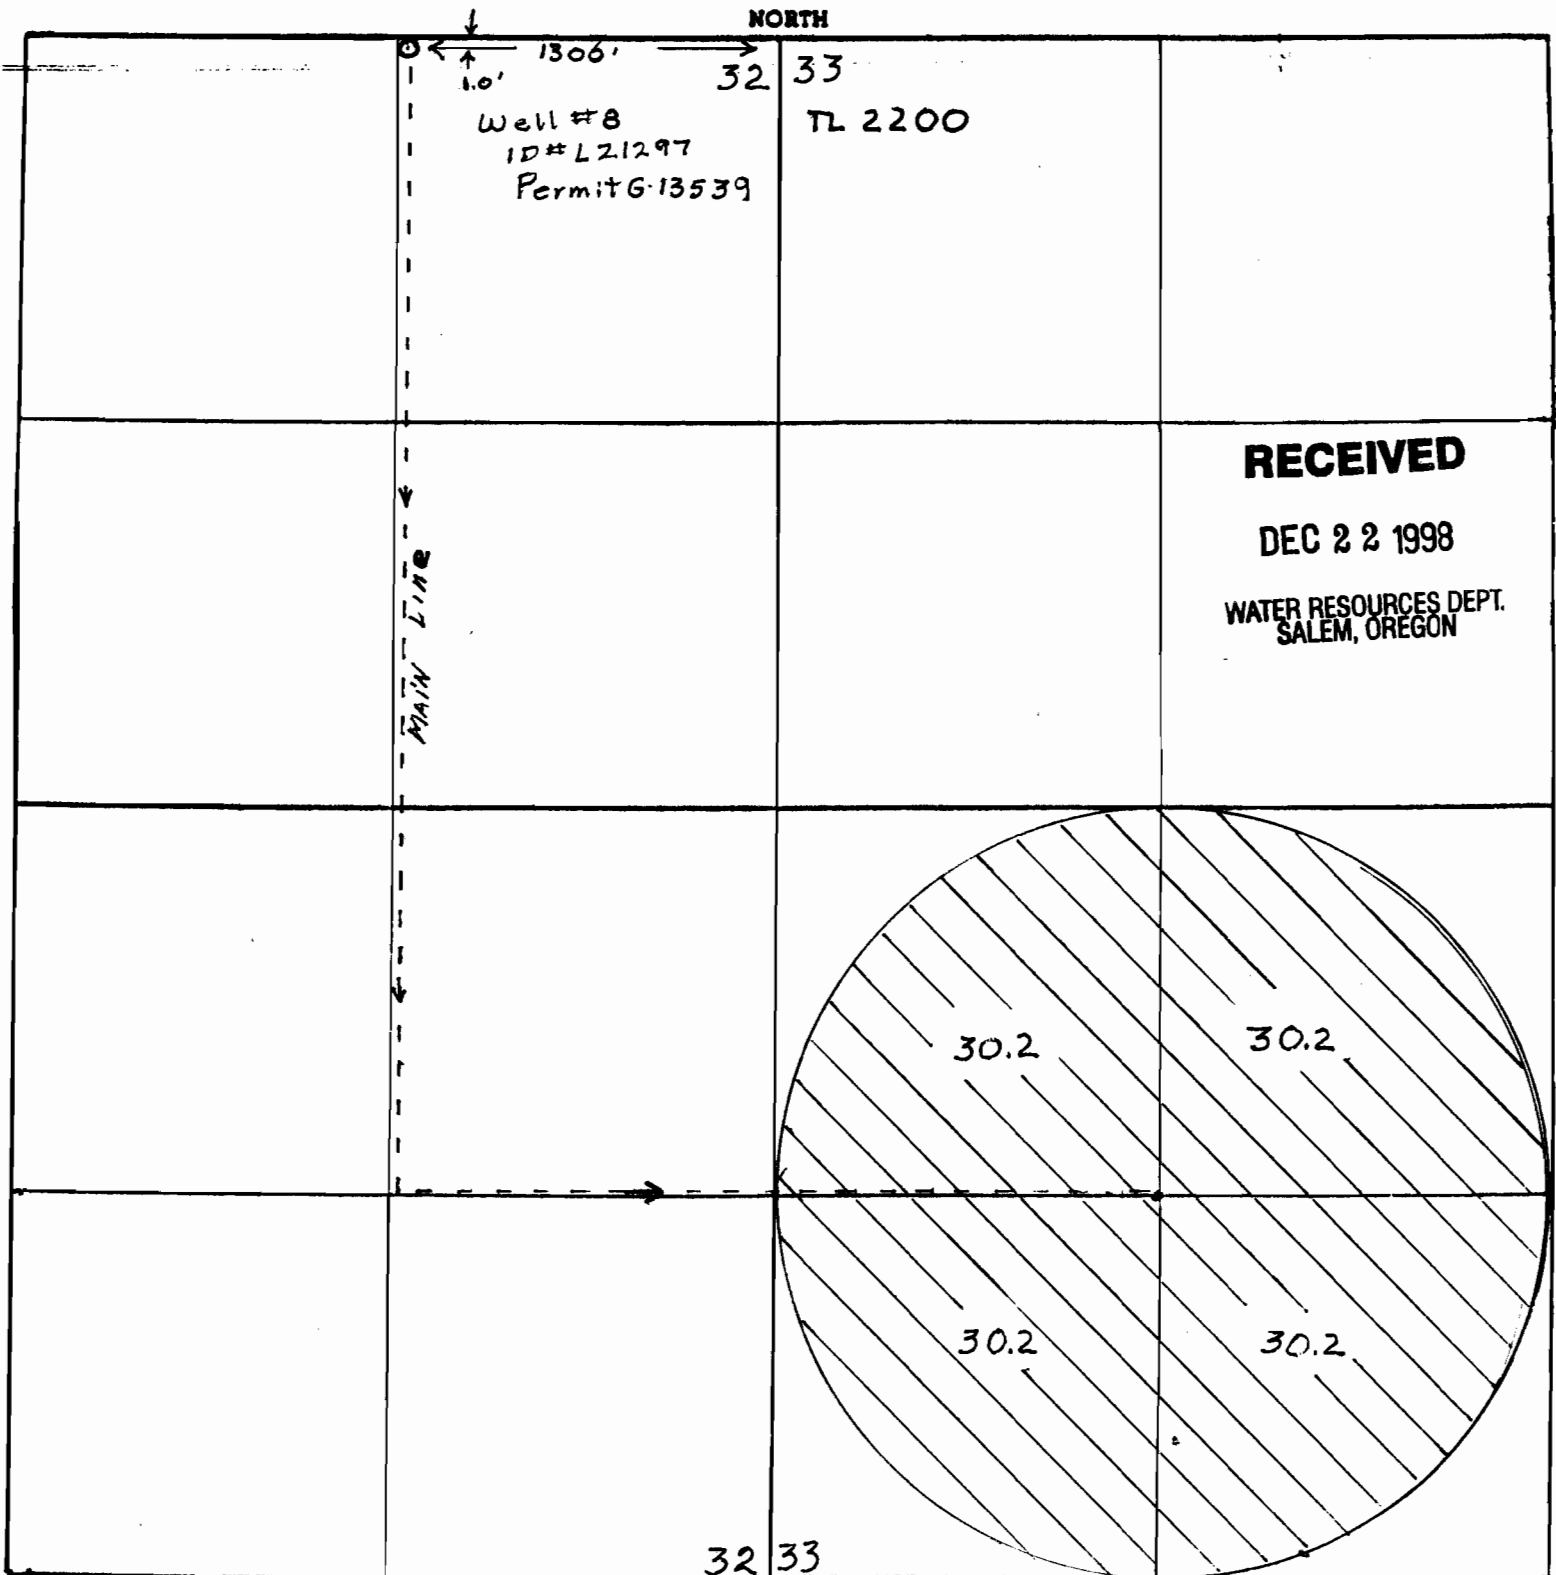

Application No. 6-14888

Permit No. SECTION PLAT

Section 34 Township 22-S Range 32 1/2-E

County of Harney State of OREGON

NORTH

