


IN THE S.1/2 OF SECTION 9, TWP.4 S. RANGE 13 E. W.M.
 WASCO COUNTY, OREGON

APPLICATION No. G-14945

PERMIT No. G-13752

IN THE NAME OF:
DANE KLINDT

DATE: NOVEMBER 3, 2004

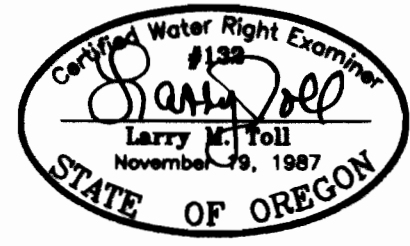

EXPIRES: 06/30/06


BY: **TENNESON ENGINEERING CORP.**
 409 LINCOLN STREET,
 THE DALLES, OREGON, 97058
 PH. (541) 296-9177
 FAX (541) 296-6657



WATER RIGHT CLAIM OF BENEFICIAL USE

SCALE: 1" = 400'

NOTE:
 AREA SHOWN AND HATCHED IS IN ORCHARD

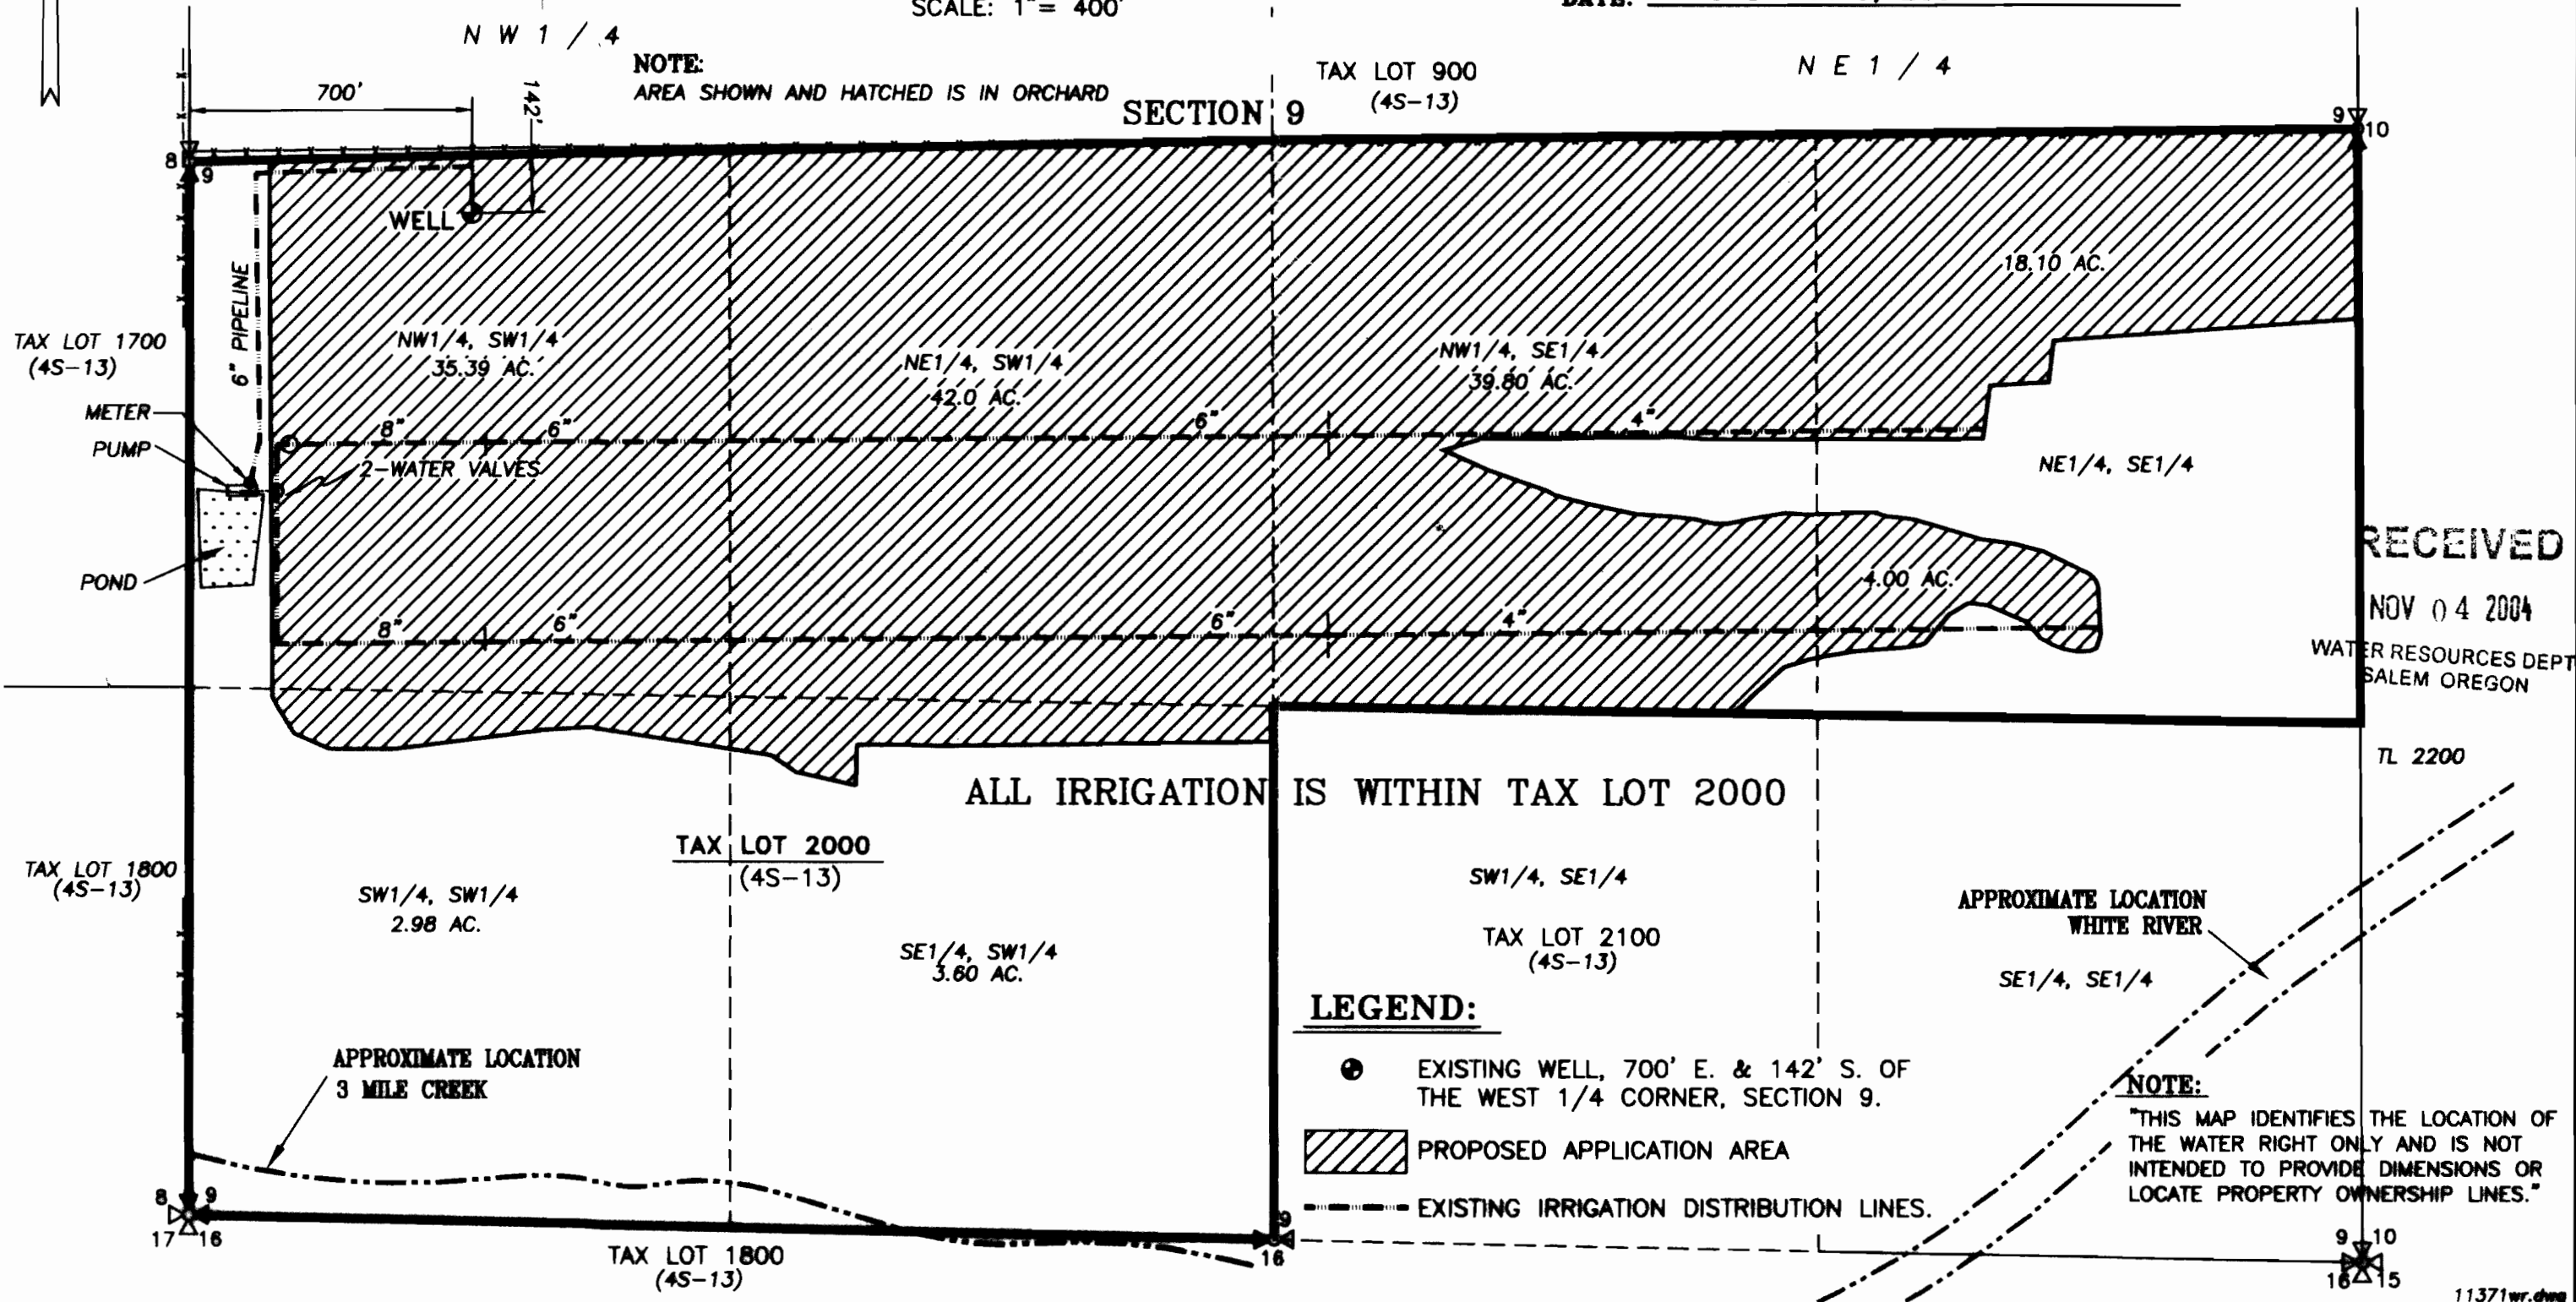

LEGEND:

- EXISTING WELL, 700' E. & 142' S. OF THE WEST 1/4 CORNER, SECTION 9.
- PROPOSED APPLICATION AREA
- - - EXISTING IRRIGATION DISTRIBUTION LINES.

NOTE:
 "THIS MAP IDENTIFIES THE LOCATION OF THE WATER RIGHT ONLY AND IS NOT INTENDED TO PROVIDE DIMENSIONS OR LOCATE PROPERTY OWNERSHIP LINES."

RECEIVED
 NOV 04 2004
 WATER RESOURCES DEPT
 SALEM OREGON