

RECEIVED


T.8 S. R.2 W. W.M.

JUN 09 1998

WATER RESOURCES DEPT.
SALEM, OREGON

10. G 14704

10. G 13761

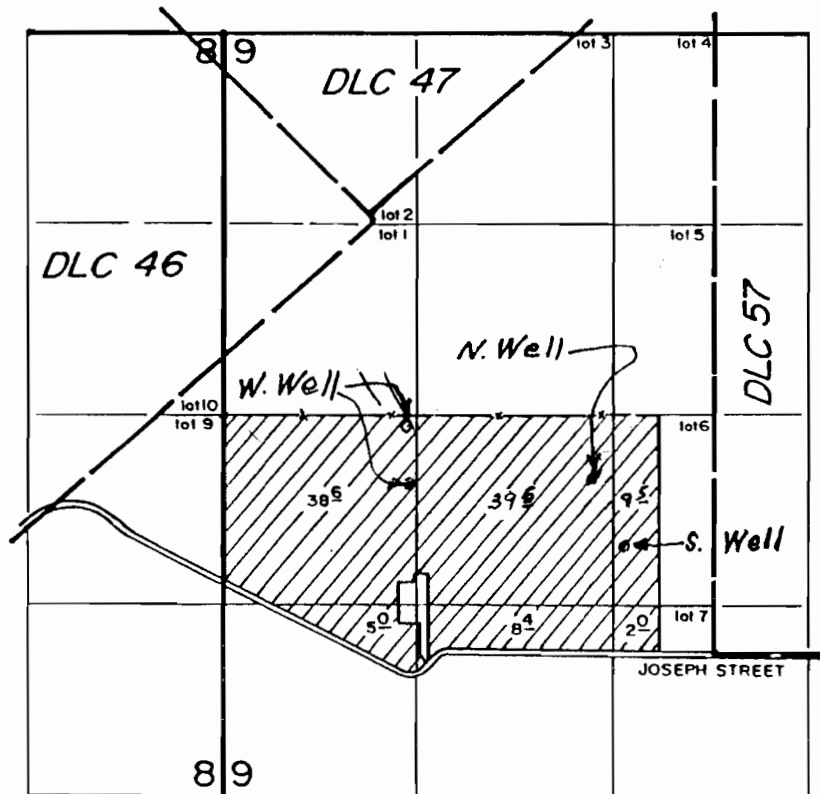

Scale
4" = 1 Mi.

N. Well loc.: 450' S & 2520' E
S. Well loc.: 920' S & 2740' E
W. Well loc.: 920' S & 1280' E
All from W 1/4 Cor. of Sec. 9

RECEIVED

MAR 16 1998

WATER RESOURCES DEPT.
SALEM, OREGON

WATER RIGHT MAP FOR
HERITAGE SEEDLINGS, INC.

THIS MAP WAS PREPARED FOR THE
PURPOSE OF IDENTIFYING THE LOCA-
TION OF A WATER RIGHT ONLY AND IS
NOT INTENDED TO PROVIDE LEGAL
DIMENSIONS OR LOCATION OF PROPER-
TY OWNERSHIP LINES.

