


Adrian
has

T. 4 S. R. 2 W. W. M.

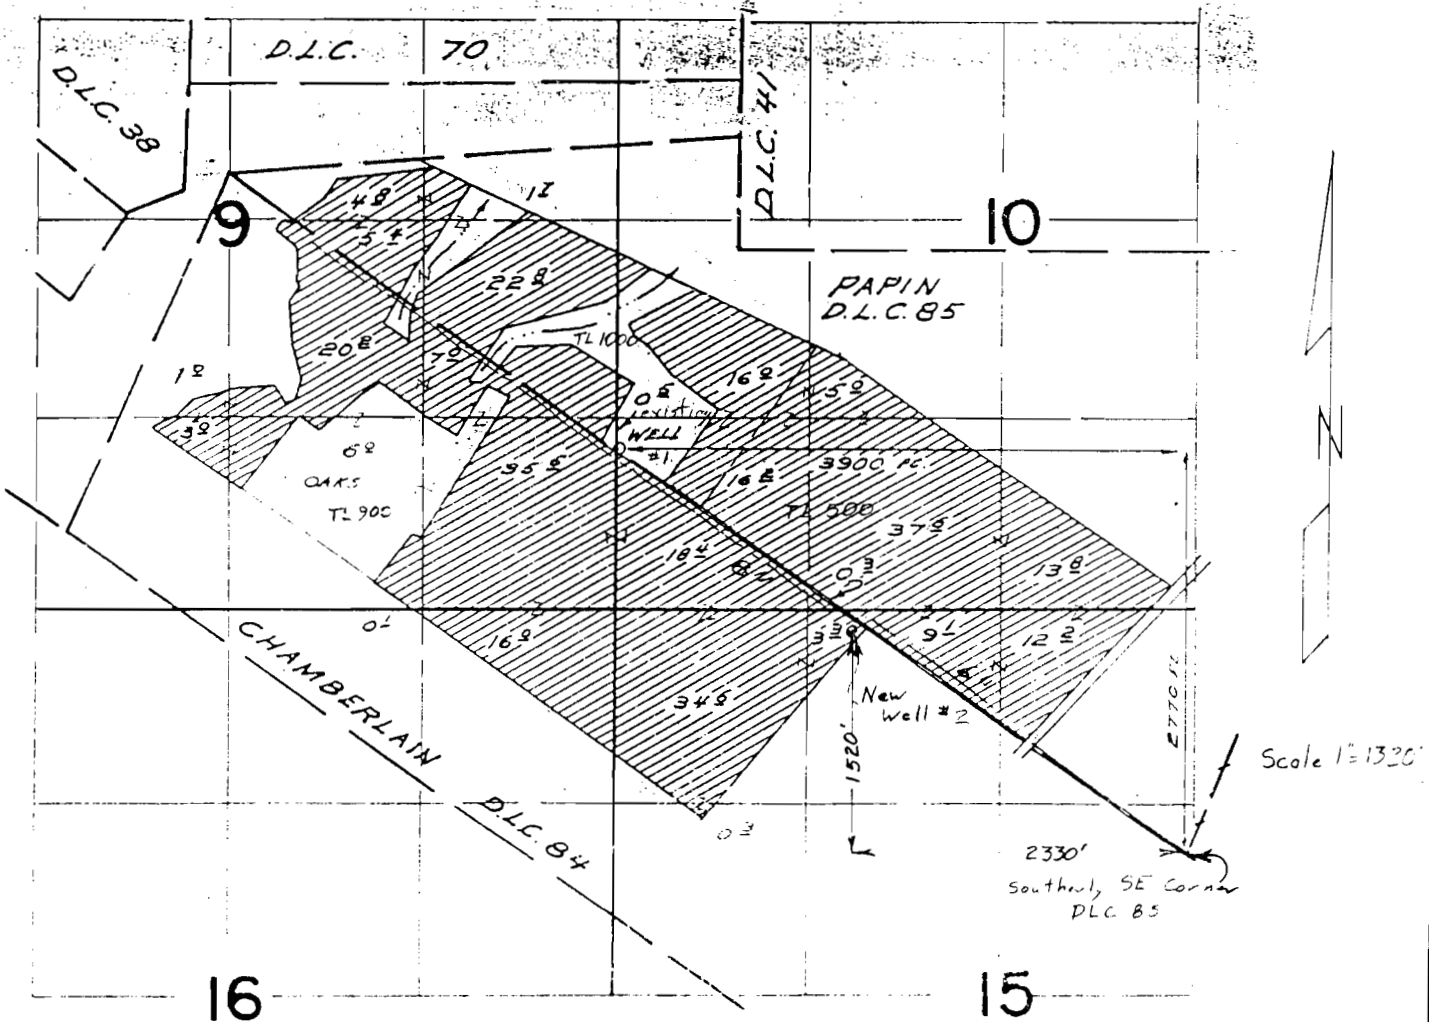


Application Map
for
BLUE SKY FARMS

Application G-14884
Permit G-

RECEIVED

OCT 01 1999

WATER RESOURCES DEPT.
SALEM, OREGON

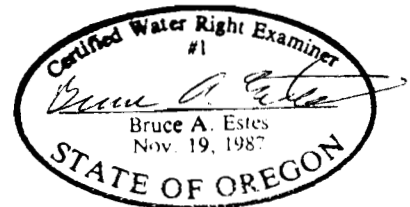

This map is for the purpose of
locating a water right only
and has no intent to provide
legal dimensions or the location
of property lines.

ESTES SURVEYS

6293 Sunnyview Rd. NE Bend, OR 97702
Salem, OR 97305 (503) 585-7593
(541) 382-7391