


J. W. Q. m. W. 12-9-99

T5S R2W

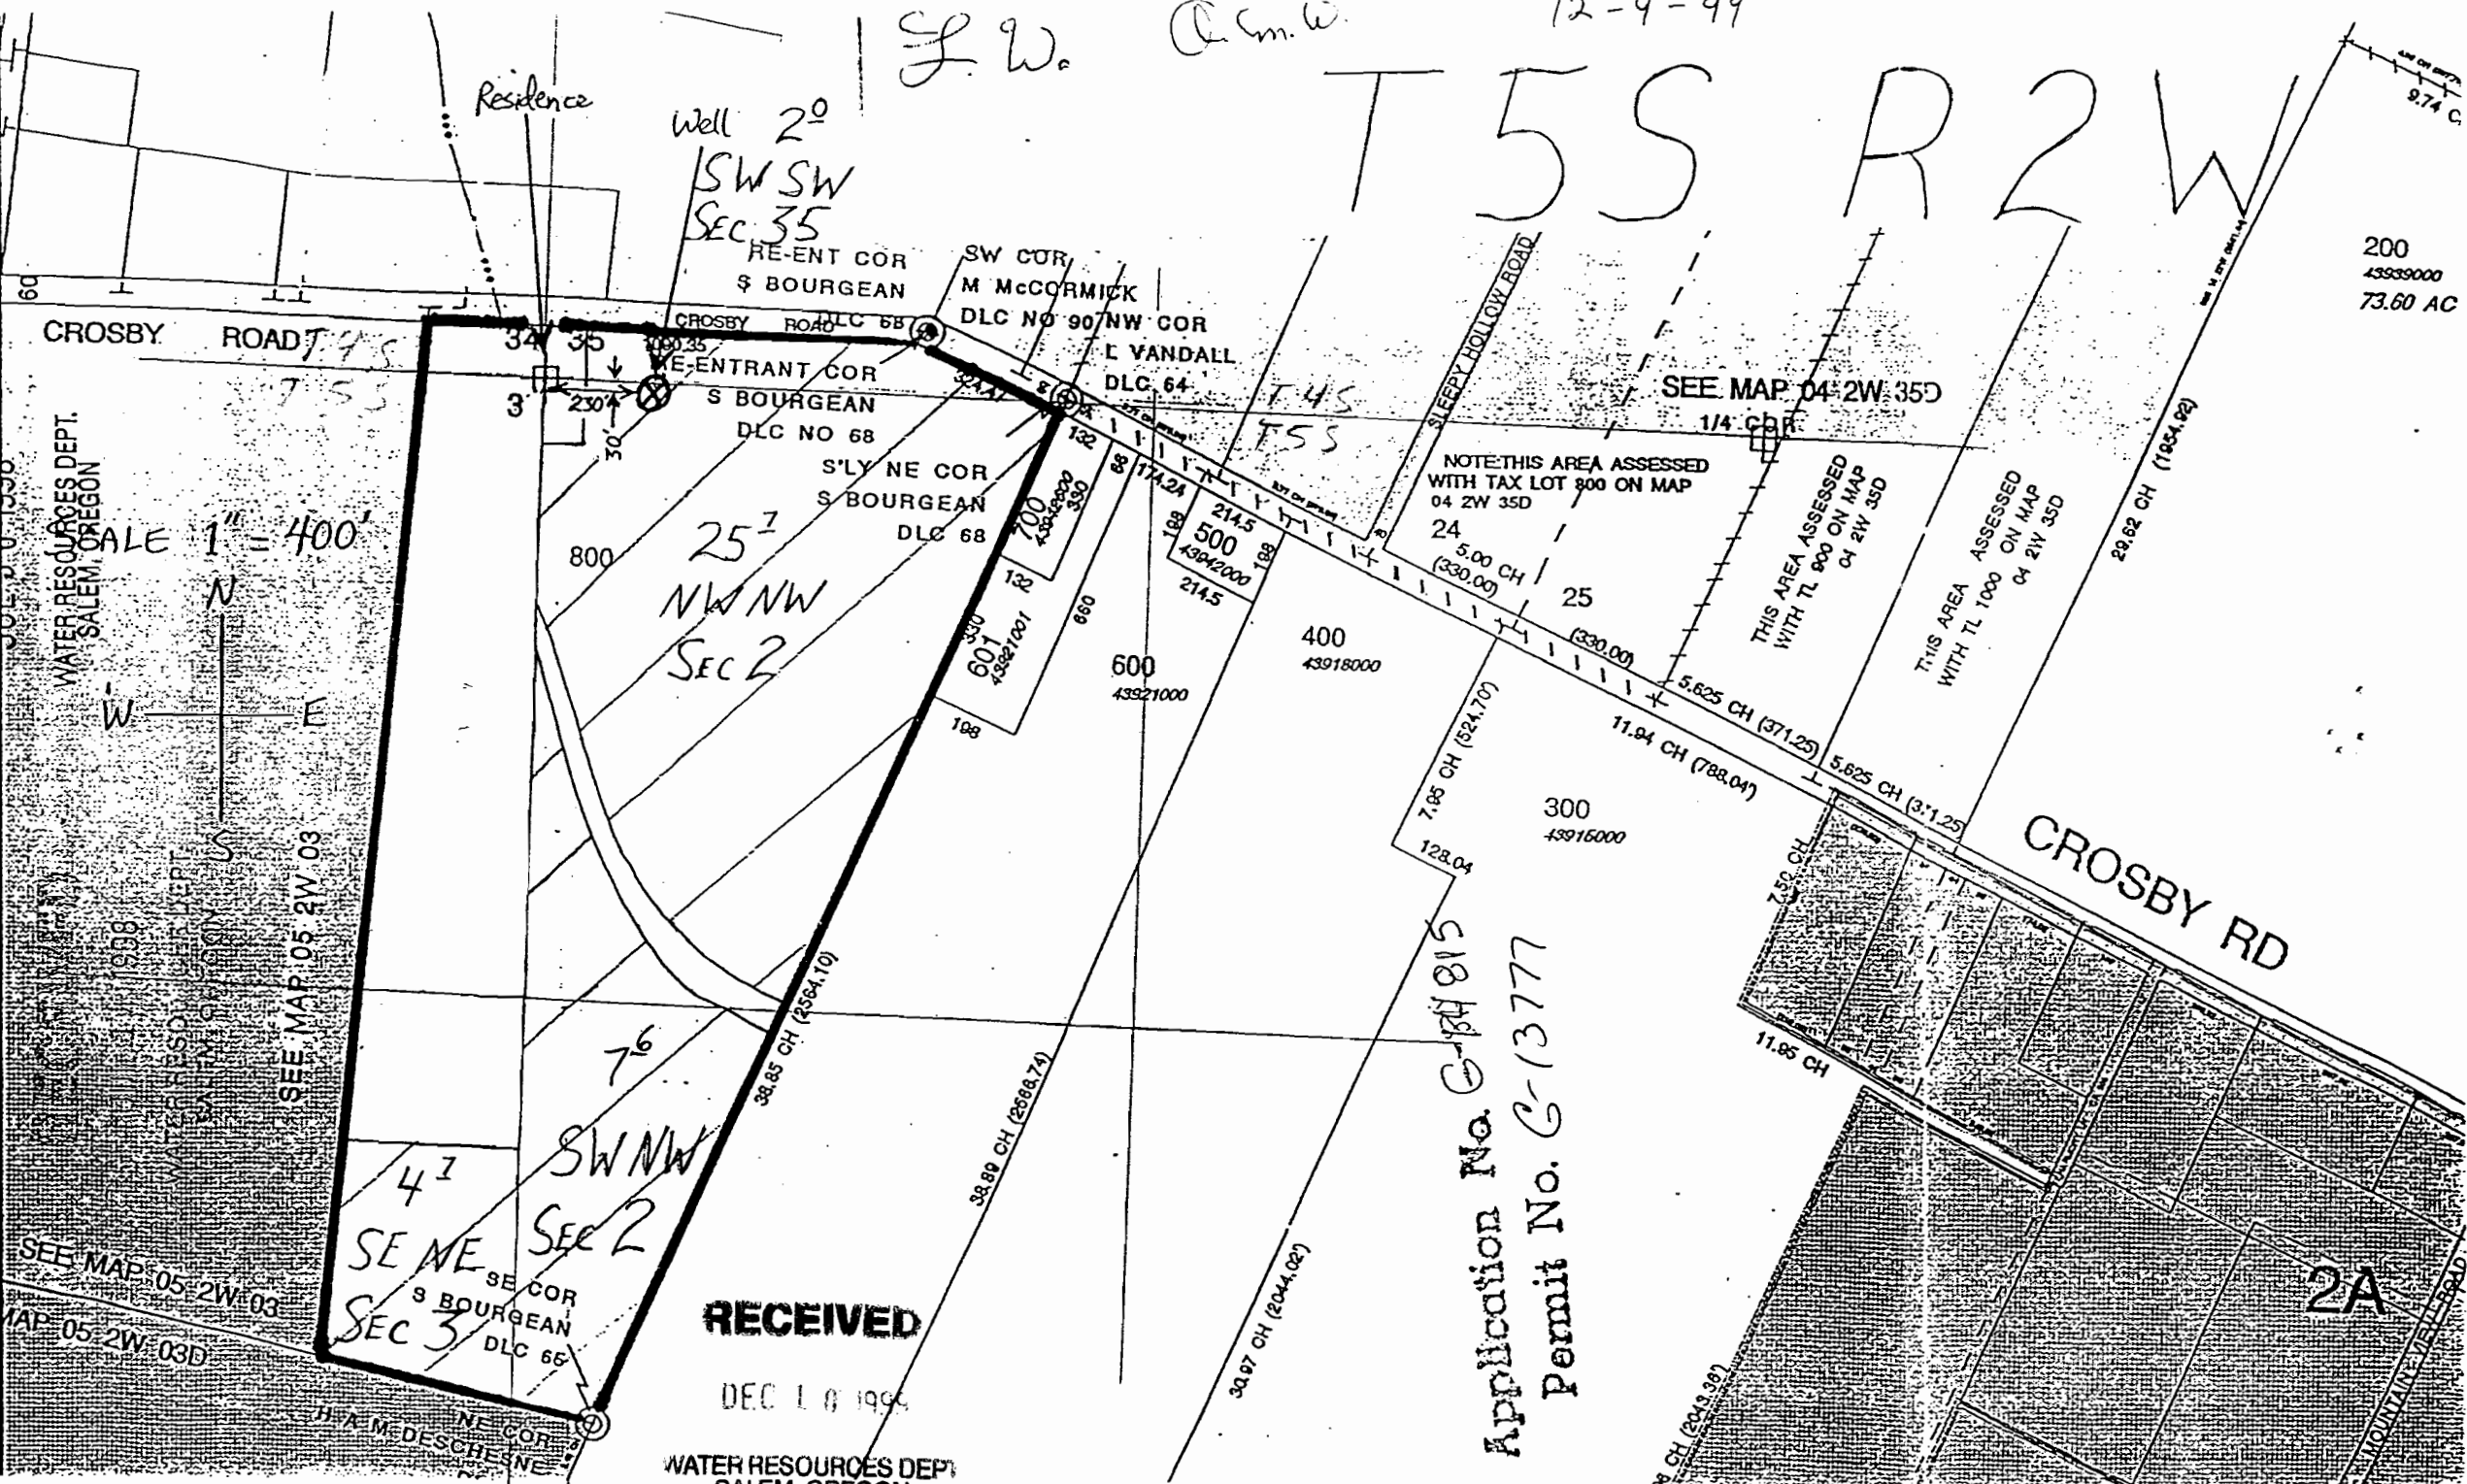

WATER RESOURCES DEPT.
SALEM, OREGON
1" = 400'

SEE MAP 05 2W 03
SEE MAP 05 2W 03D

RECEIVED
DEC 1 8 1999
WATER RESOURCES DEPT.
SALEM, OREGON

Application No. G-134815
Permit No. G-13777

200
43939000
73.60 AC

2A