


FINAL PROOF SURVEY MAP

T 6 S R 1 W, W.M.
Portion sections 22 & 23

Prepared for Golden Valley Farms
Application G-14629 Permit G-13780

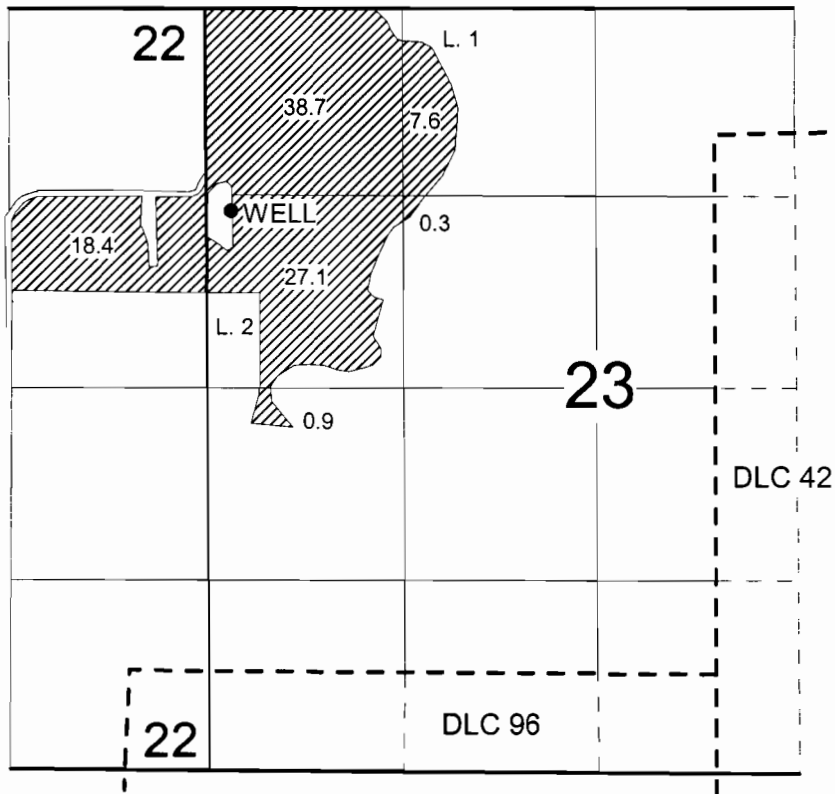

WELL: 1400' S & 160' E from the NW corner section 23

1" = 1320'



0

2500

This map is for water
right purposes only.

