

RECEIVED

# T.6S. & 7S., R.3W., W.M

RECEIVED


JAN 25 1999

DEC 28 1998

WATER RESOURCES DEPT  
SALEM, OREGON

WATER RESOURCES DEPT  
SALEM, OREGON

1000 0 1000 2000 feet

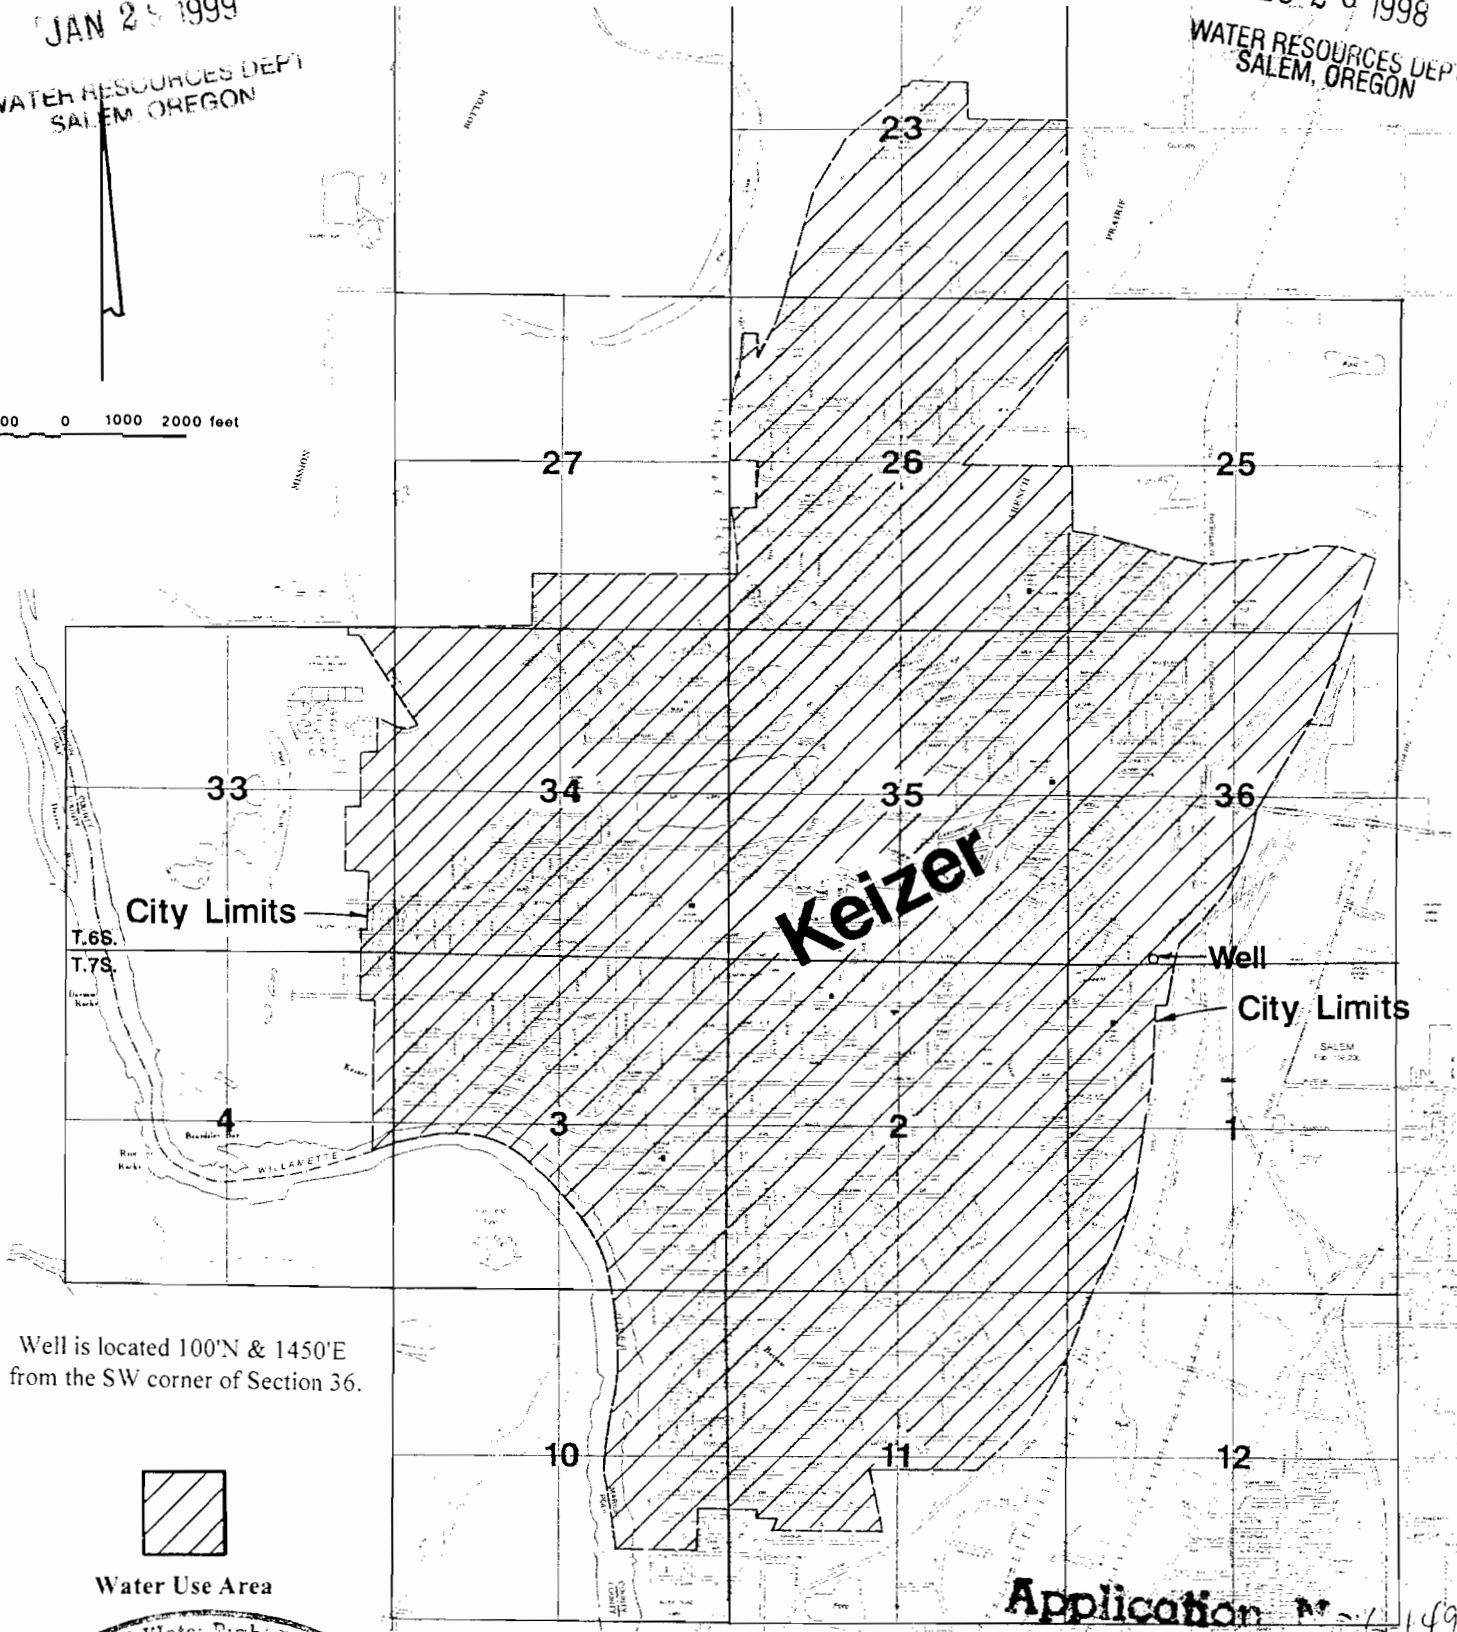

City Limits

## Keizer

Well

City Limits

Well is located 100'N & 1450'E  
from the SW corner of Section 36.



Water Use Area

Application # 14916



Application Map

Permit No.

### City of Keizer

Application #: C-14916 Permit #: C-13784

This Map Was Prepared For The Purpose Of Identifying The Location Of A Water Right Only And Is Not Intended To Provide Legal Dimensions Or Location Of Property Ownership Lines.