


T-25-S R-37-E
HARNEY County

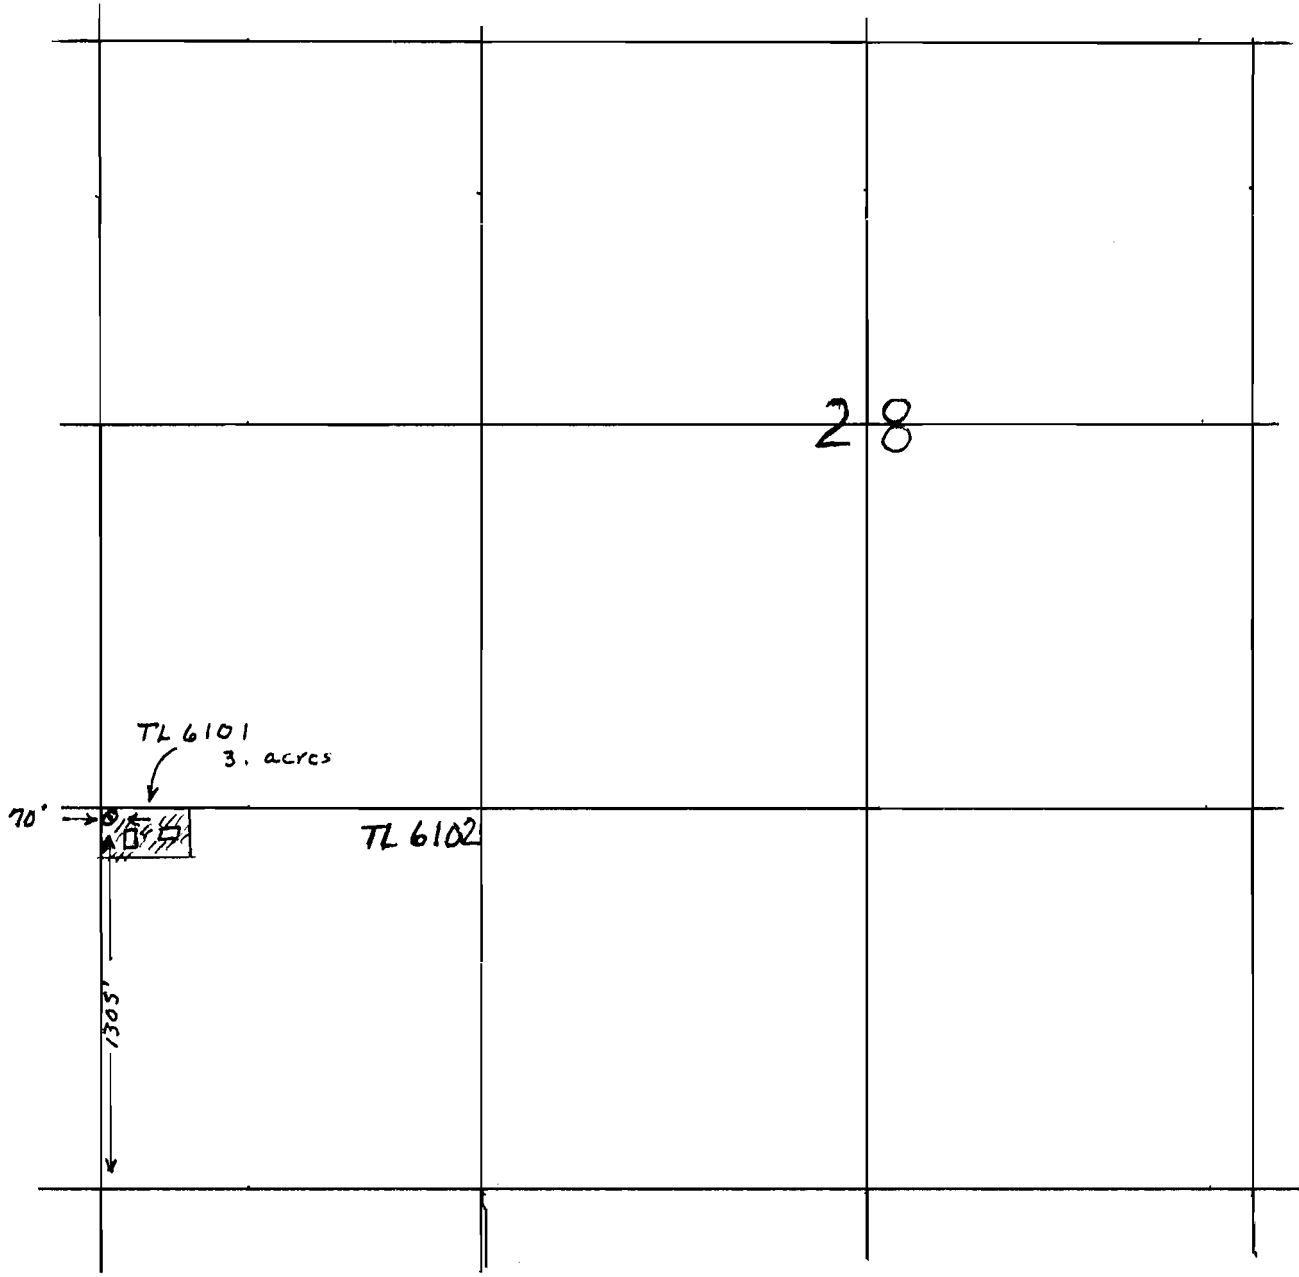

RECEIVED
MAY 22 2000
WATER RESOURCES DEPT
SALEM, OREGON



domestic and Lawn & Garden for 2 Houses

Application G-14974

Permit # G-13822