


Well #4 is Located  
 205 Ft. N and 306 E  
 of S.W. corner of  
 the NW $\frac{1}{4}$ -SE $\frac{1}{4}$  of  
 Sec. 5, T 38S, R 10E,  
 W.M.

Application No G-14993  
 Permit No.

Application No. G-856  
 Permit No. G-764



RECEIVED  
 JUN 21 2000  
 WATER RESOURCES DEPT.  
 SALEM, OREGON

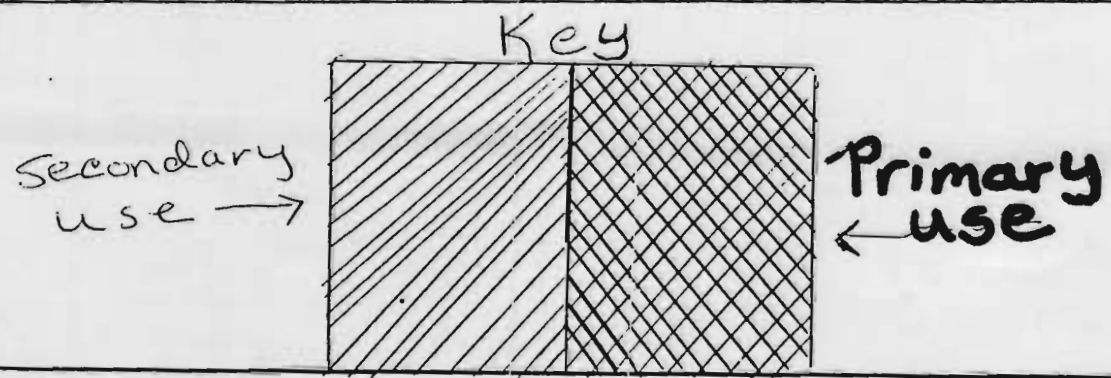

RECEIVED  
 JUN 1 1999  
 WATER RESOURCES DEPT.  
 SALEM, OREGON

MAF  
 LANDS TO  
**BAR**  
 KLAMATH C  
 Sc  
 Map