


T 4 N R 34 E

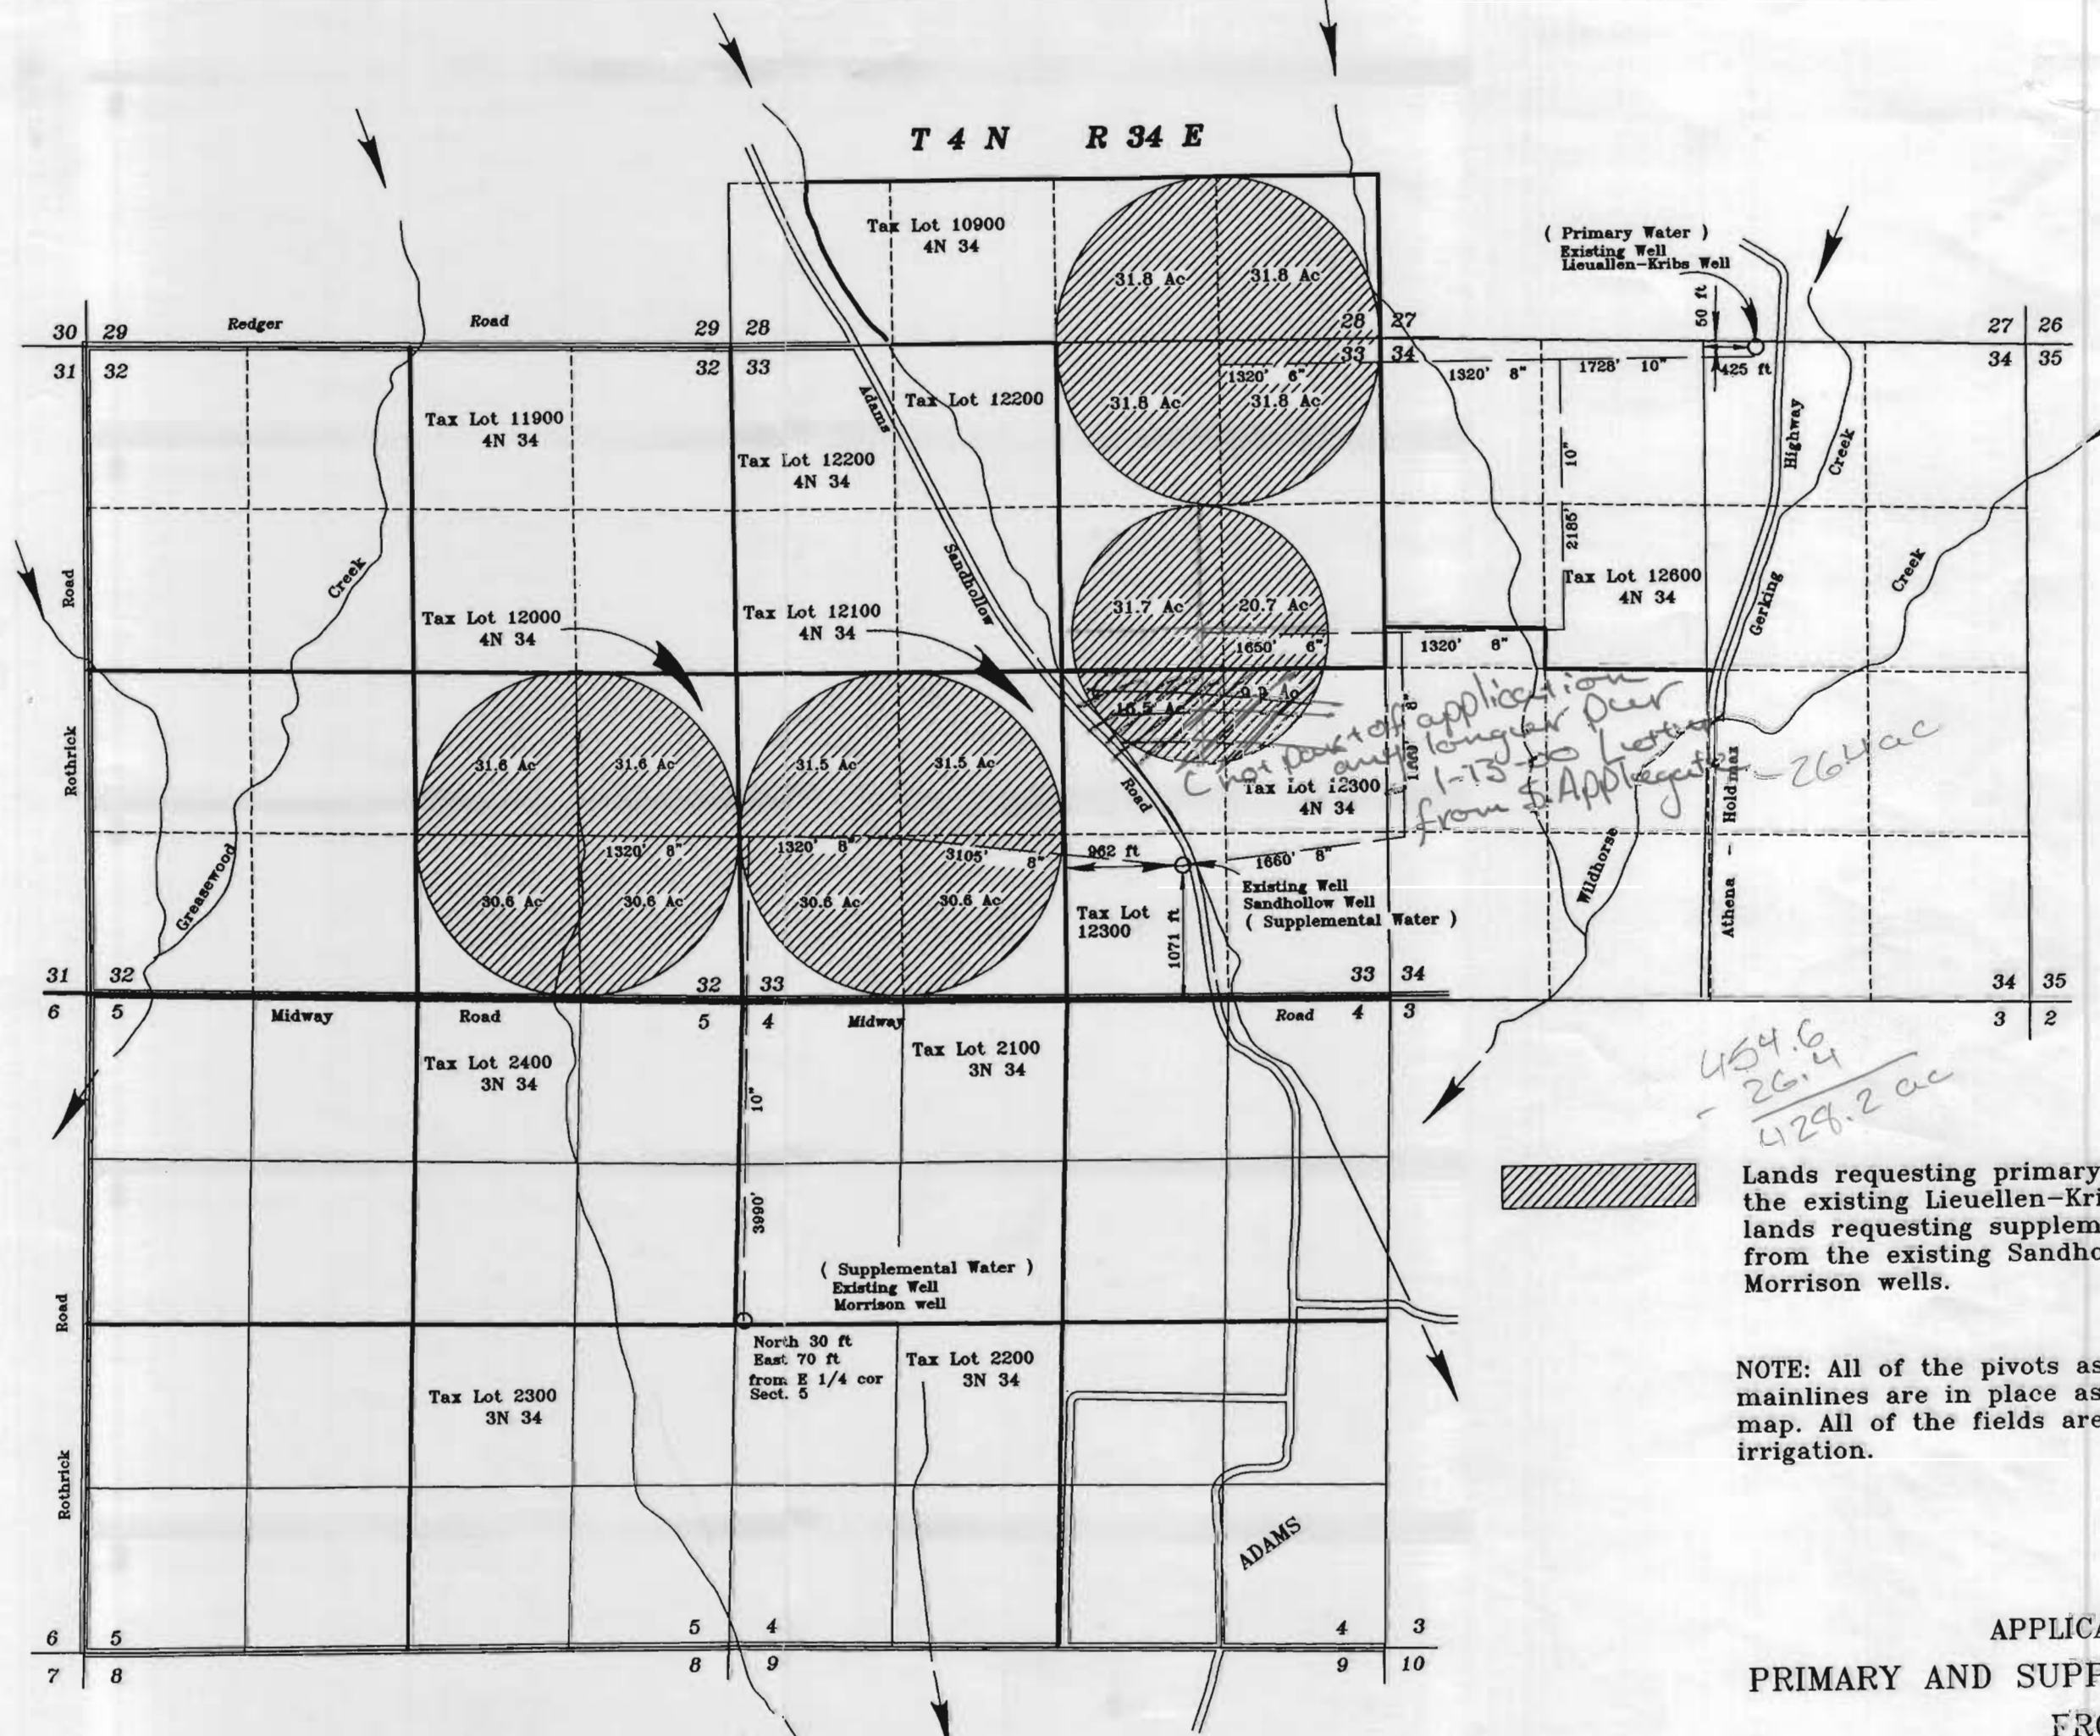

Lands requesting primary w the existing Lieuallen-Kribs lands requesting supplemen from the existing Sandhollo Morrison wells.

NOTE: All of the pivots as w mainlines are in place as s map. All of the fields are r irrigation.

454.6
- 26.4

428.2 ac

APPLICATI
PRIMARY AND SUPPLI
FROM