


T 4 N, R 28 E, WM  
UMATILLA COUNTY

RECEIVED

FEB 13 2004

PLANNING & ENGINEERING

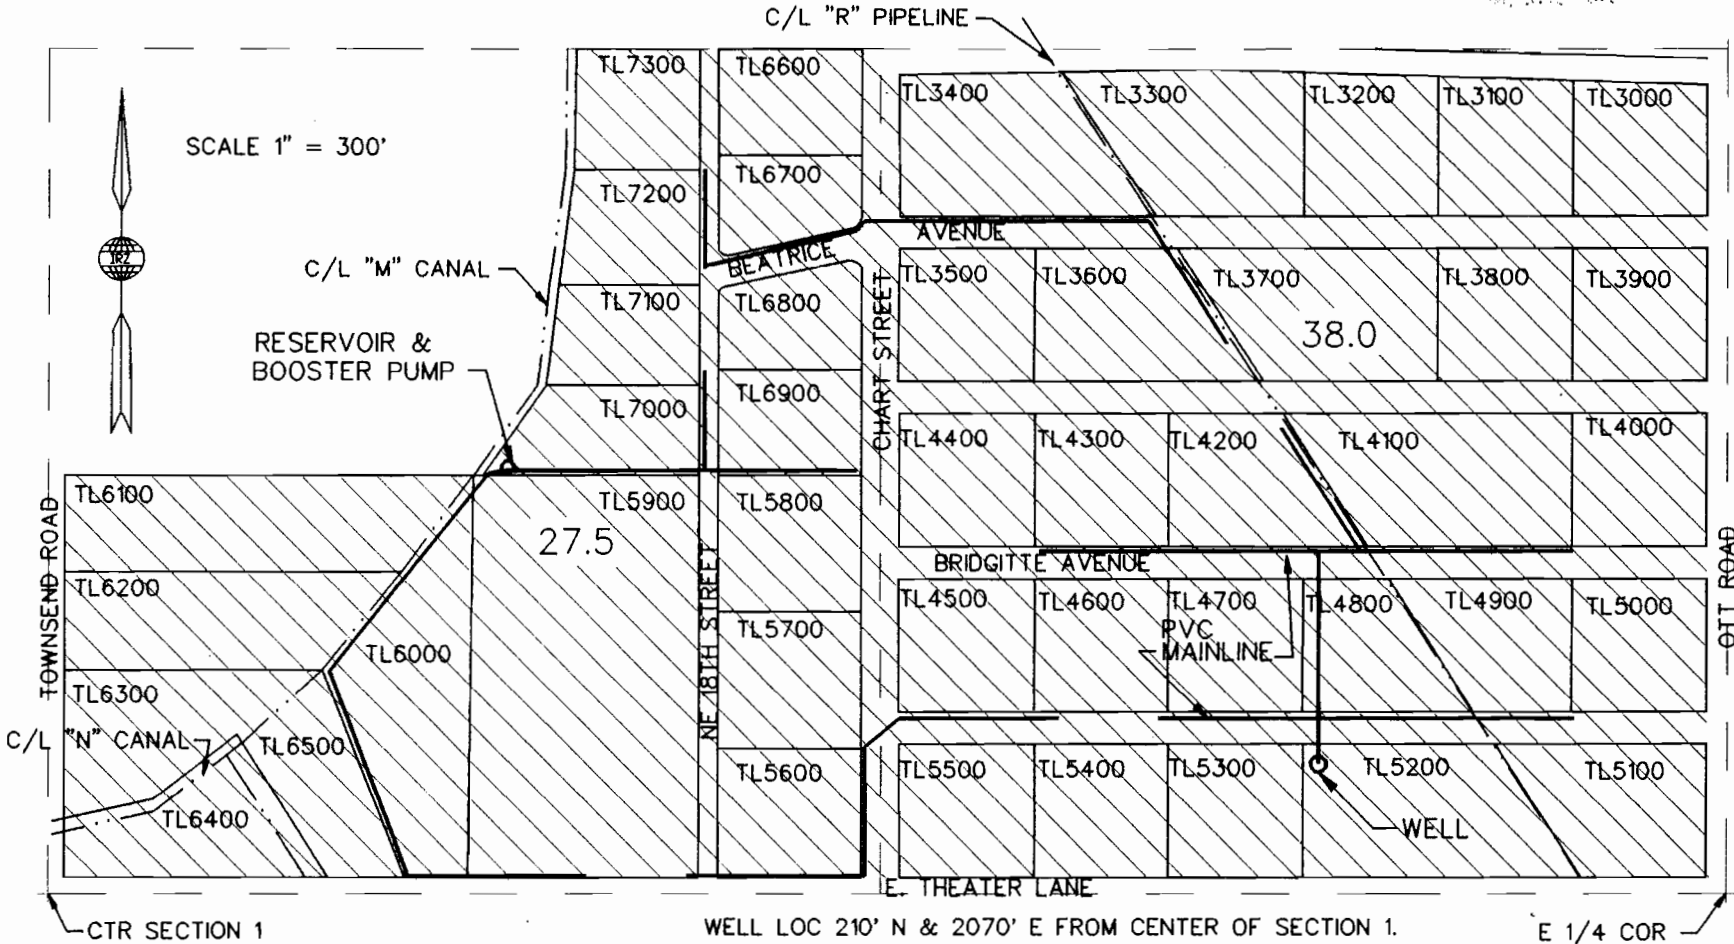


FINAL PROOF SURVEY

UNDER

APP NO G-15004 PERMIT NO G-13852

IN NAME OF

CHART WATER SUPPLY, INC

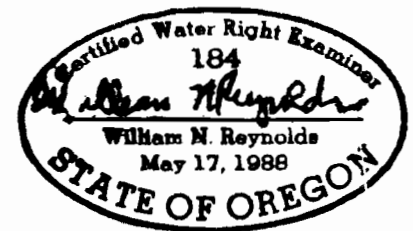

THE PREPARATION OF THIS MAP IS FOR THE PURPOSE OF IDENTIFYING THE LOCATION OF WATER RIGHTS ONLY, AND HAS NO INTENT TO PROVIDE DIMENSIONS OR LOCATIONS OF PROPERTY OWNERSHIP LINES.