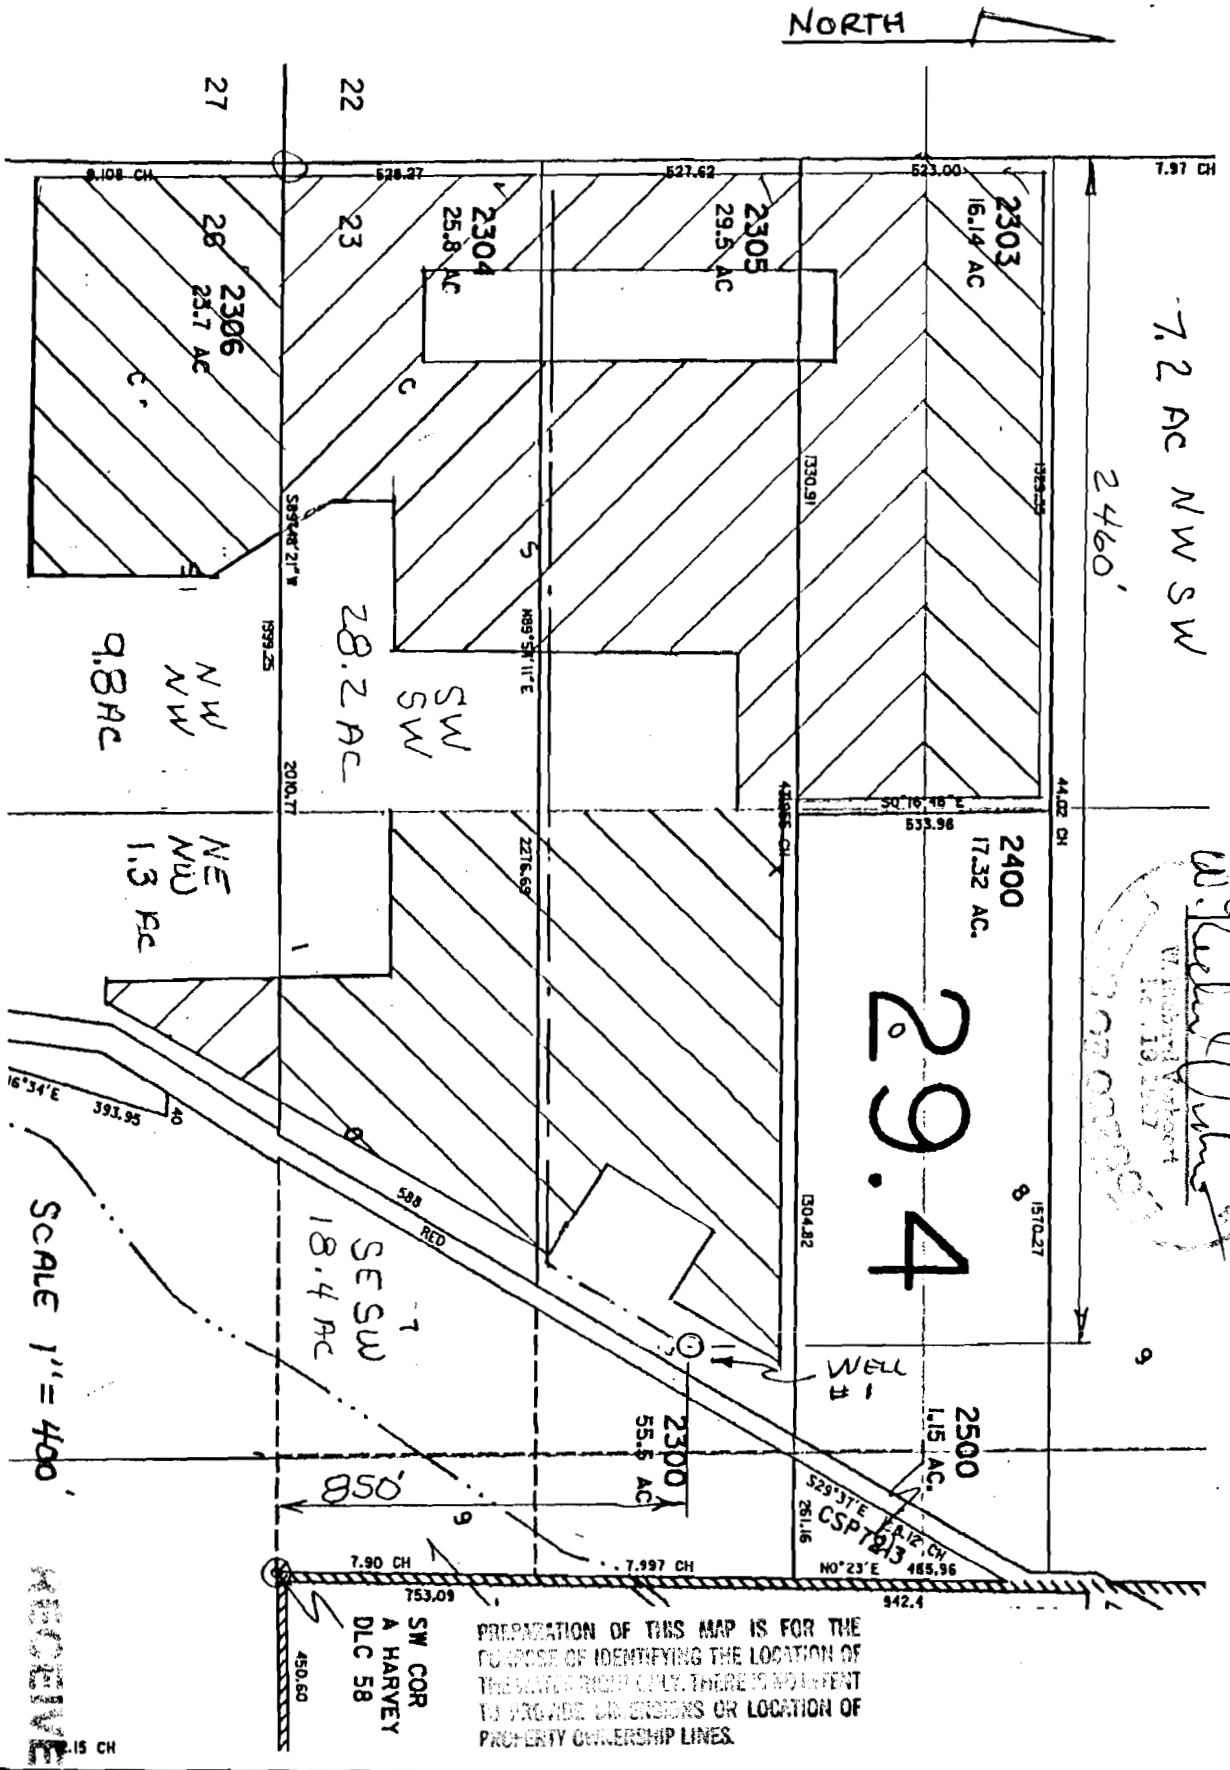

VERBOORT ENGINEERING
AGRICULTURE · CIVIL · WATER RESOURCES
HILLSBORO, OREGON

	by	date
designed	WW	6-00
drawn	WW	6-00
checked		
drawing no.	00-A-09	
sheet no.	1/1	

BERNARD & RONNI LACROUTE
19143 NE LAUGHLIN RD
YAMHILL, OR 97148

APPLICATION G-15012