


000 00 00 0

ACREAGE - ALL ACREAGES EXCLUDE ANY PORTION THAT MAY LIE WITHIN THE INDICATED PUBLIC RIGHT OF WAYS.

TICK MARKS - WHEN A TICK MARK IS INDICATED ON THE EXTENSION OF A LINE, THEN THE DIMENSION GOES TO THE TICK MARK. GENERALLY THIS IS USED WHEN DIMENSIONS GO INTO PUBLIC RIGHT OF WAYS.

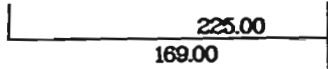

ARROWS ARE USED WITH DIMENSIONS IN AREAS OF GREATER COMPLEXITY.

NOTICE: This map was created for Assessor's Office use ONLY.


Assessor's Office logo with 'We Care' slogan and 'GIS Geographic Information System' text.

RECEIVED stamp dated JUL 24 2000 from WATER RESOURCES DEPT SALEM, OR.

SCALE 1" = 400' or 1:4800

Plot file created: January 28, 1998

Application No. Permit No. G-13929

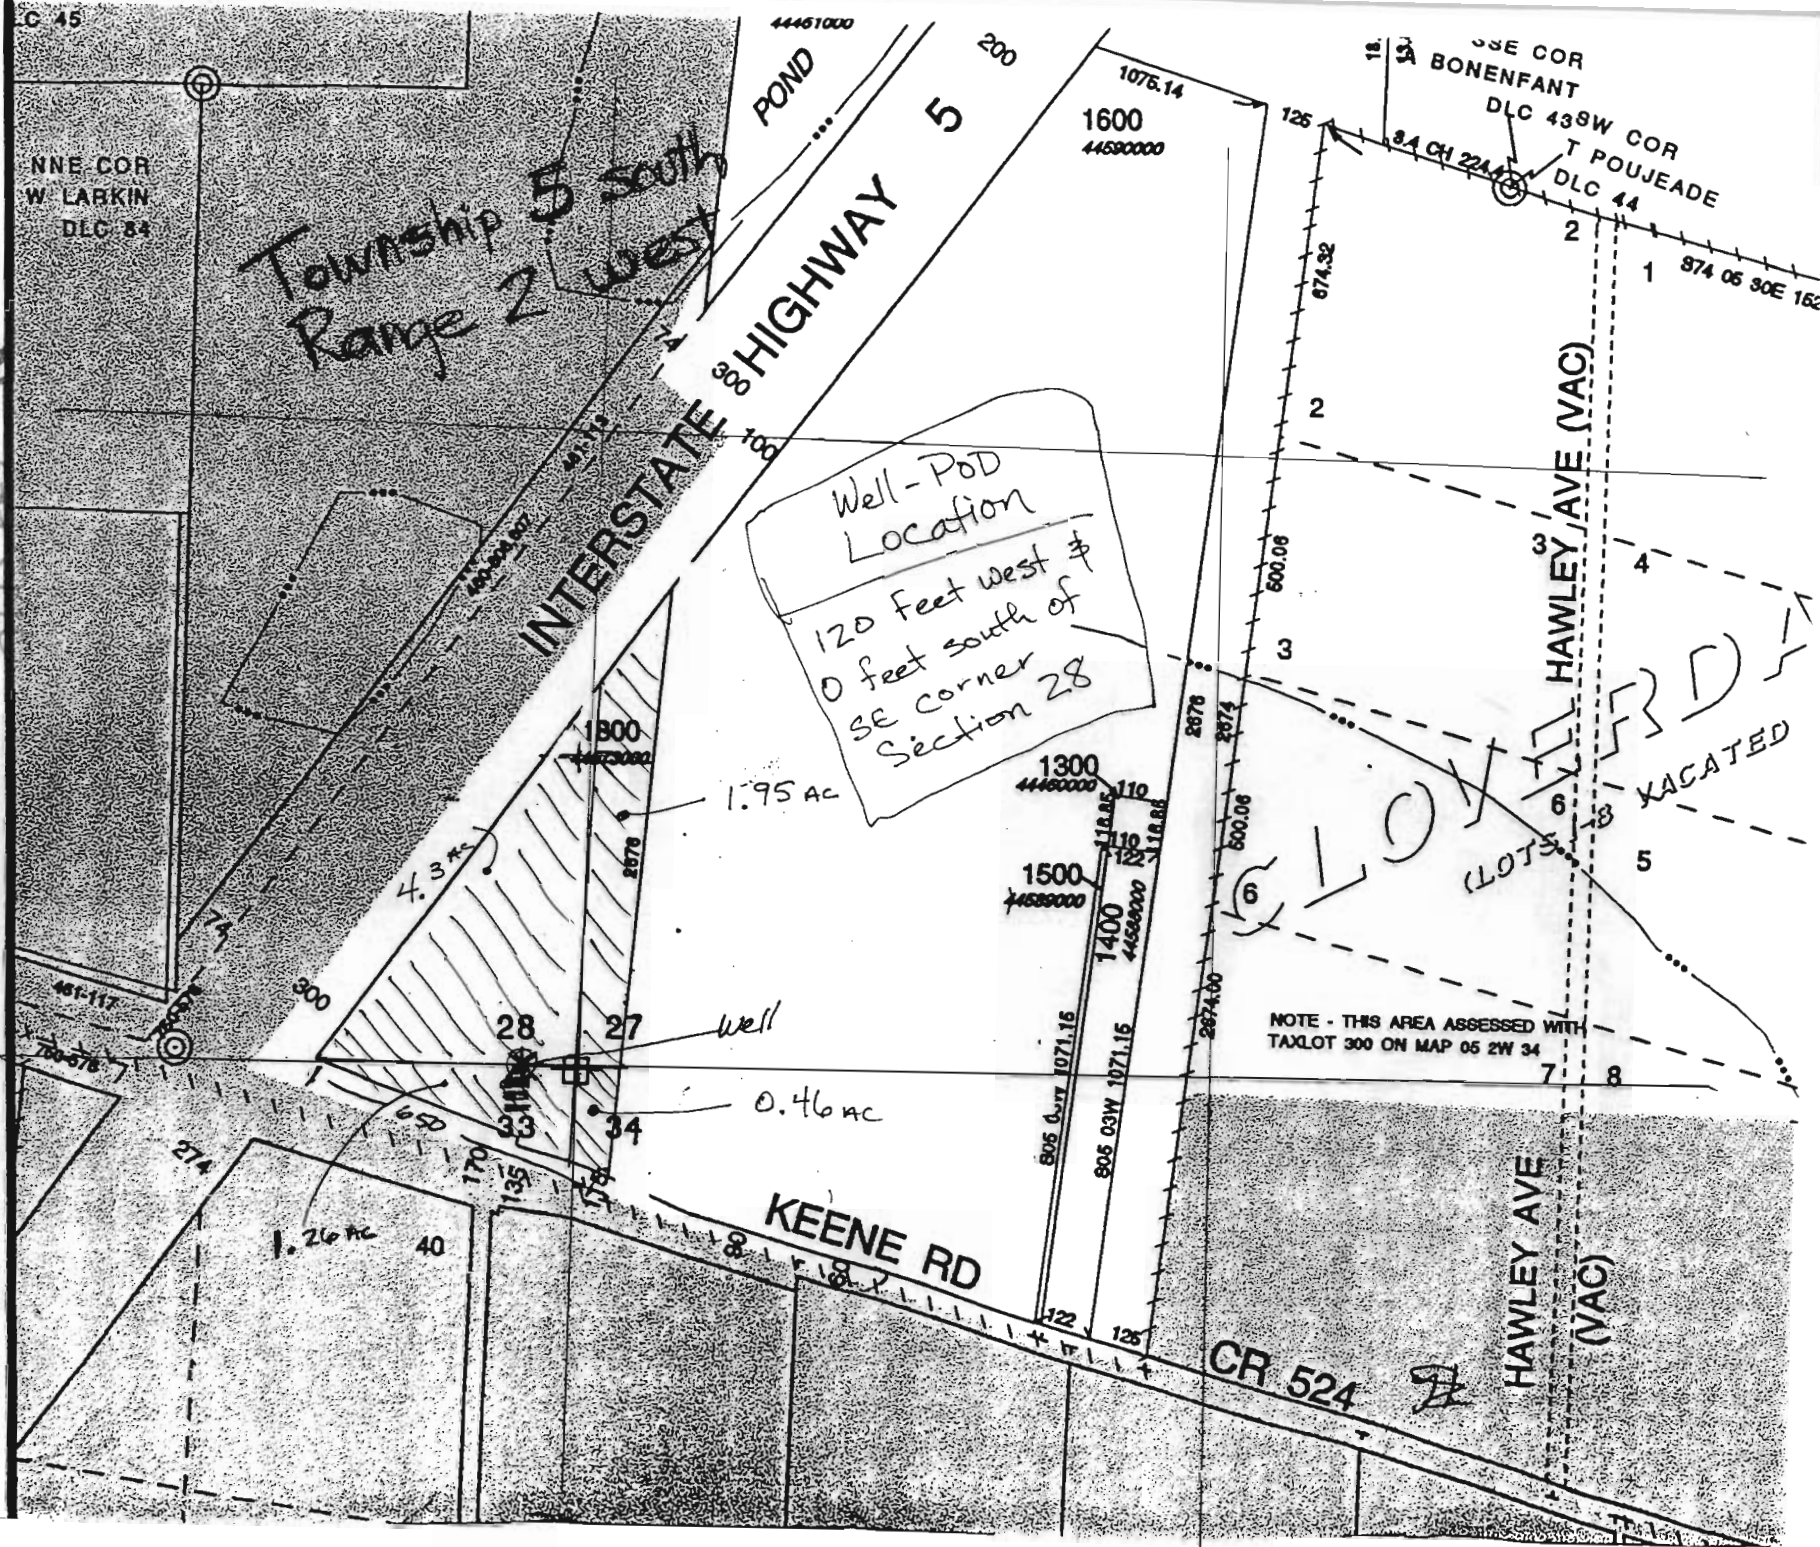

NOTE - THIS AREA ASSESSED WITH TAXLOT 300 ON MAP 05 2W 34