

T. 5N., R. 28E., W.M.

UMATILLA COUNTY

SCALE 1" = 400'

Baggett Lane

27

28 27

33 34

34

Tax Lot Map 5N 28 34B
Application #G-12171
Permit #G-12348



3.6 Acres
Tax Lot 503

980 Ft

Well

2540 Ft.

CANAL

Sunshine Lane

Well Located 980 Ft. South and 2540 Ft. West of the North Quarter Corner
of Section 34, Township 5 North, Range 28 East, W.M., NW 1/4 of the NW 1/4
Lat. 45° 52' 36.505" N Long. 119° 18' 23.700" W WGS84

WATER RIGHTS PROOF MAP




Water Use Found at This Location

IN NAME OF

JOAN TROUT

34

THIS MAP IS FOR THE PURPOSE
OF IDENTIFYING THE LOCATION
OF WATER RIGHTS ONLY AND IS
NOT INTENDED TO PROVIDE THE
LEGAL DIMENSIONS OR LOCATIONS
OF PROPERTY OWNERSHIP LINES.

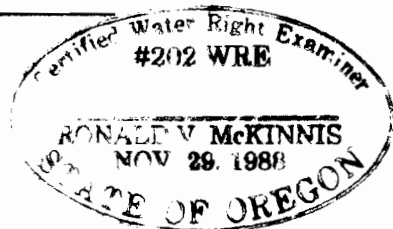

ENGINEERING - LAND SURVEYING - WATER RIGHTS
R. V. McKINNIS ENGINEERING



79980 Prindle Loop Road
Hermiston, Oregon 97838
(541) -567-2017

