

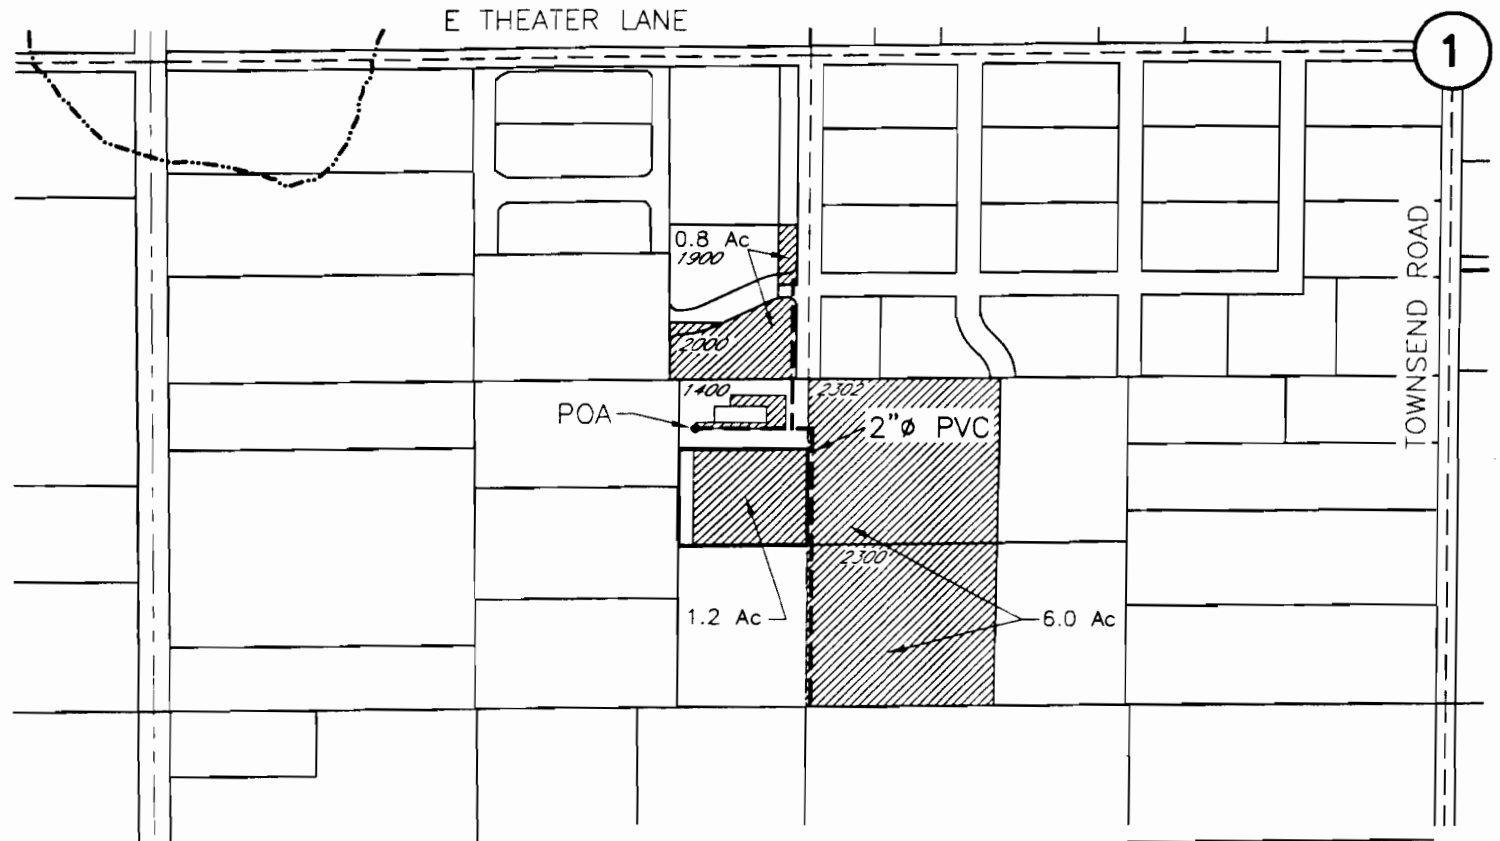
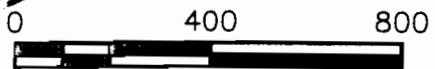


**FINAL PROOF MAP
FOR PERMIT G-13983
JIM & PAM ENNEKING
SW 1/4 SEC 1, T 4N, R 28 E. WM**

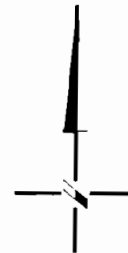

POA
WELL - LOCATED 775'S AND 1120' E FROM
THE W 1/4 CORNER SEC 1, T 4N, R 28 E. WM

AREA TO BE IRRIGATED

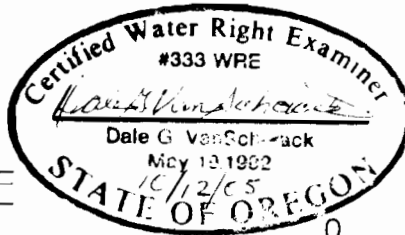

SCALE IN FEET

NOTE:
THE PURPOSE OF THIS MAP IS TO IDENTIFY THE APPROXIMATE LOCATION
OF THE WATER RIGHT. IT IS NOT INTENDED TO PROVIDE INFORMATION
RELATIVE TO THE LOCATION OF PROPERTY OWNERSHIP BOUNDARY LINES.

DRAWING: H:\CAD\AG\3522\127\3522307\3522127FP.dwg
PRINTED BY: Roger Willard on 10/12/05 06:52 AM