

Application No. G 15170


RECEIVED

Permit No. G-14038

JUN 15 2000

MAP TO ACCOMPANY APPLICATION TO APPROPRIATE GROUND WATER  
LOCATED WITHIN  
NE 1/4, NE 1/4, SECTION 26, T. 6 N., R. 35 E., W.M.  
UMATILLA COUNTY, OREGON  
APPLICANT: UPPER COLUMBIA MISSION SOC. OF SEVENTH DAY ADVENTISTS  
CHURCH

WATER RESOURCES DEPT.  
SALEM, OREGON

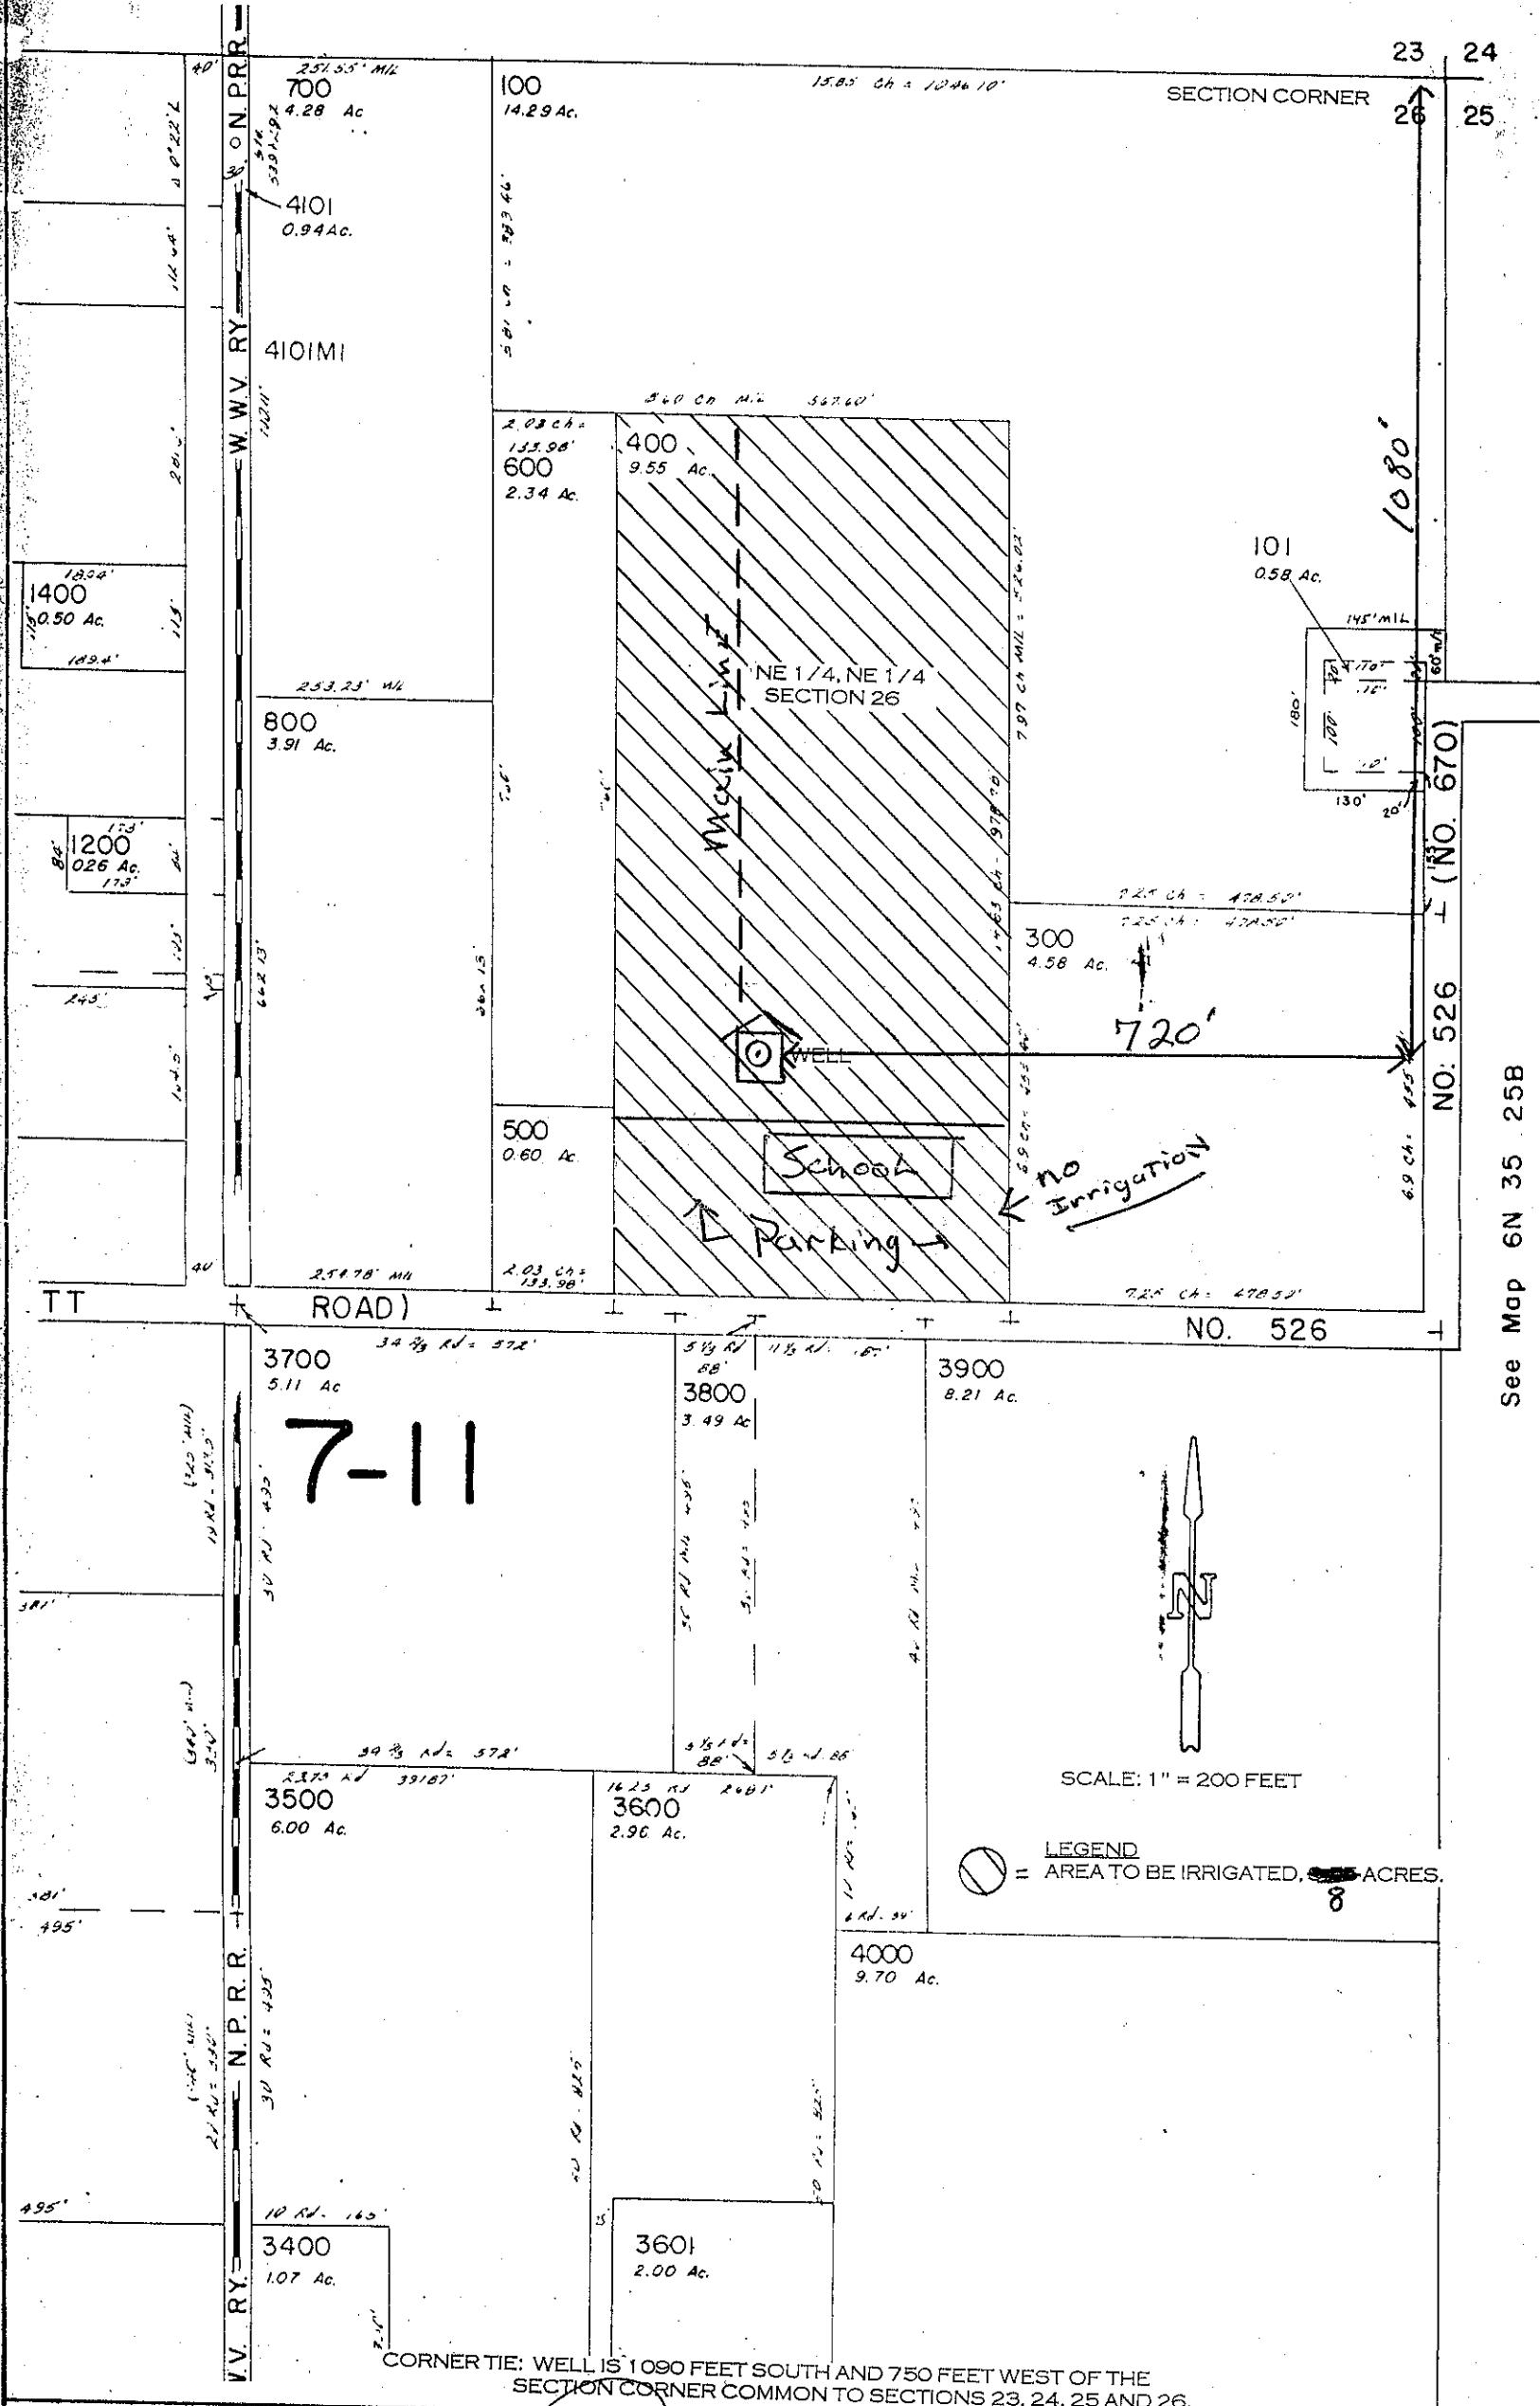

See Map 6N 35 25B

THIS MAP IS PREPARED FOR THE EXPRESS PURPOSE TO SHOW WATER APPROPRIATION AND USE. IT IS NOT INTENDED TO SHOW OR LOCATE PROPERTY OWNERSHIP LINES.

Certified Right Examiner  
# 53  
*Dennis L. Gaylord*  
Dennis L. Gaylord  
Nov. 19, 1987  
STATE OF OREGON

DENNIS L. GAYLORD, CWRE  
71614 S.W. LAKE DRIVE  
PENDLETON, OR 97801  
541-276-6260  
FEBRUARY 2000