


Township 5 North, Range 29 East, W.M.

SE 1/4 of NW 1/4 of Section 28

2021
2928

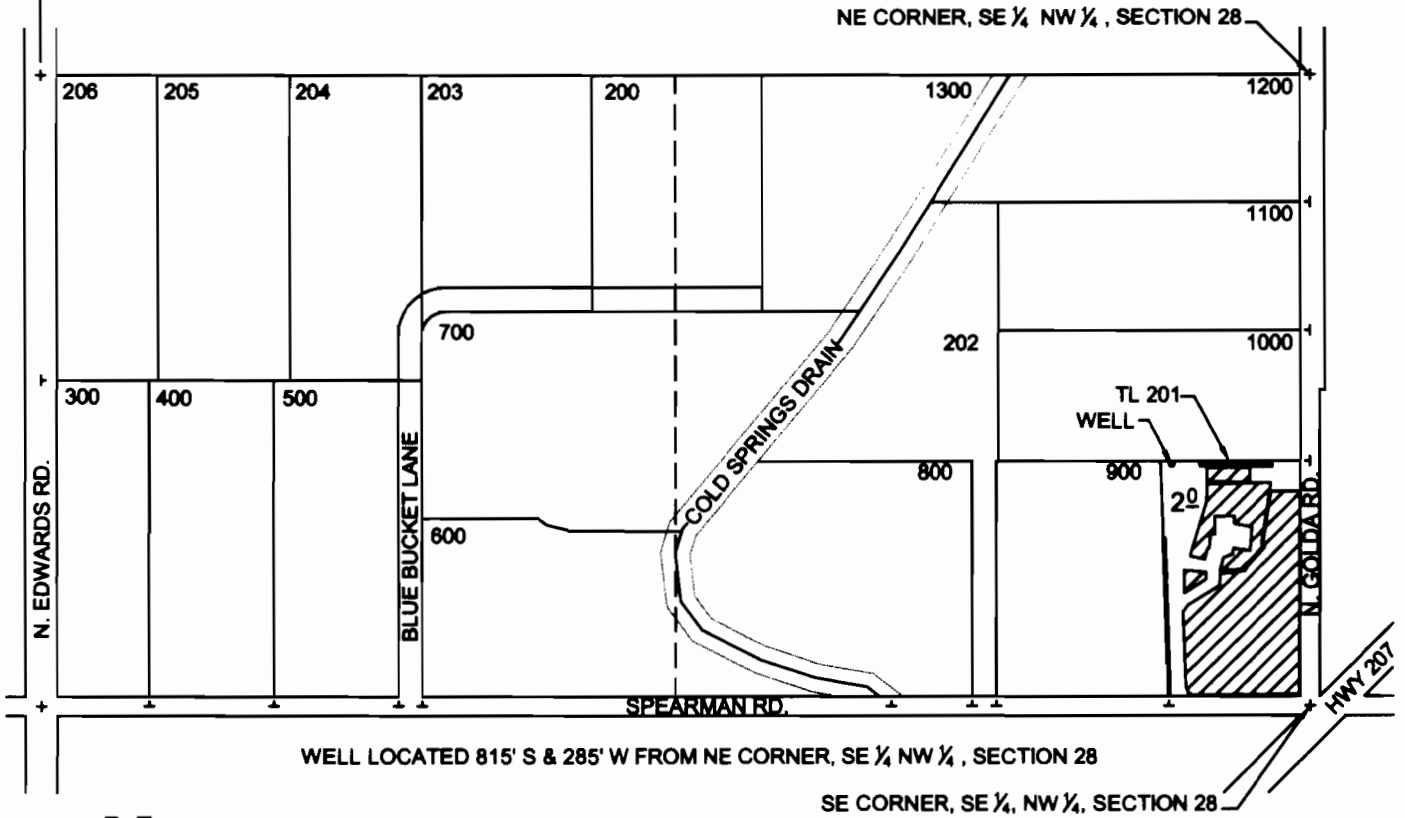


SCALE 1" = 400'

FINAL PROOF SURVEY
under
Appl. No. G-15163, Per. No. G-14041
in name of
RICK AND JAN ROCK
August 28, 2006

RECEIVED

OCT 16 2006

WATER RESOURCES DEPT
SALEM OREGON

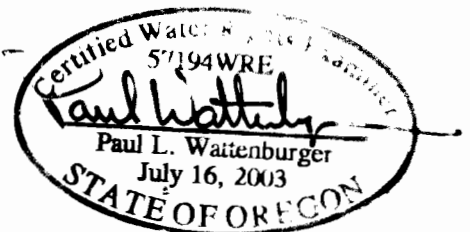

EXPIRES 6/30/08

THIS MAP WAS PREPARED FOR THE PURPOSE OF IDENTIFYING THE LOCATION OF A WATER RIGHT ONLY AND IS NOT INTENDED TO PROVIDE LEGAL DIMENSIONS OR LOCATION OF PROPERTY OWNERSHIP LINES.