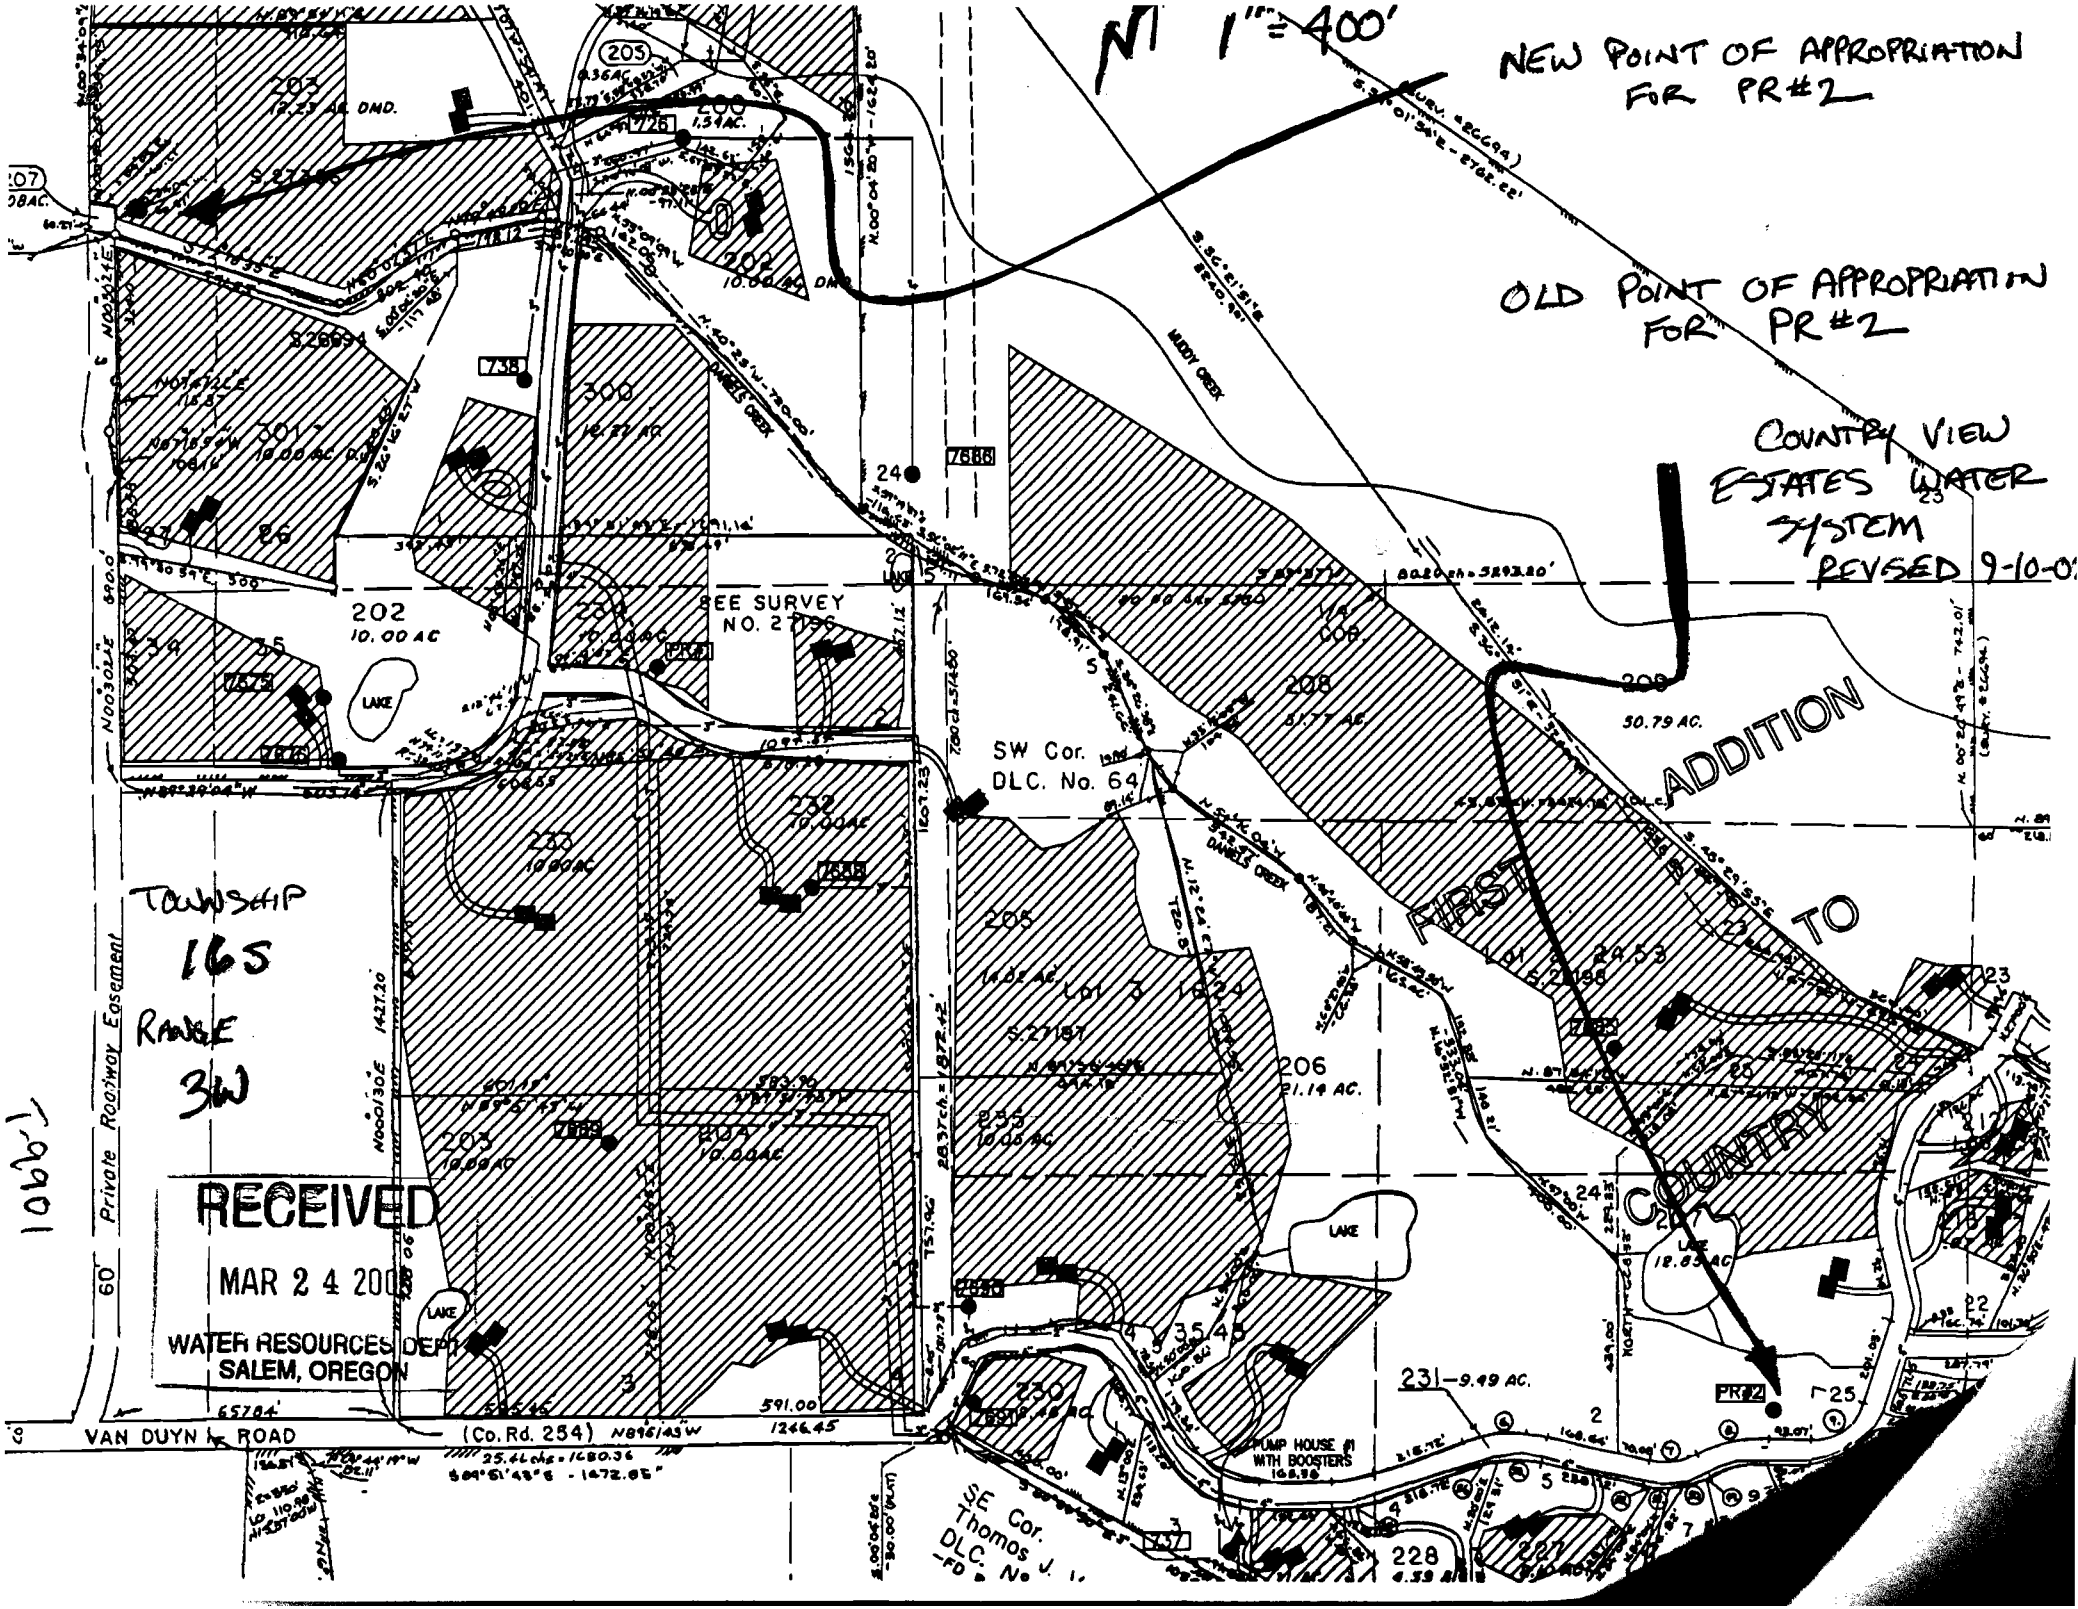
N 1"=400'
NEW POINT OF APPROPRIATION FOR PR#2
OLD POINT OF APPROPRIATION FOR PR#2
COUNTRY VIEW ESTATES WATER SYSTEM
REVSED 9-10-0
SEE SURVEY NO. 27196
SW Cor. DLC. No. 64
SE Cor. Thomos J. DLC. No.
FIRST ADDITION TO COUNTRY
TOWNSHIP 16S
RANGE 3W
T9901
RECEIVED
MAR 2 4 2008
WATER RESOURCES DEPT
SALEM, OREGON
VAN DUYN ROAD (Co. Rd. 254)
Private Roadway Easement
PUMP HOUSE #1 WITH BOOSTERS
LAKE
MUDDY CREEK
DANIELS CREEK
202 10.00 AC
203 10.00 AC
204 10.00 AC
205 14.06 AC
206 21.14 AC
207 12.23 AC
208 51.7 AC
230 10.00 AC
231 9.49 AC
232 10.00 AC
300 16.27 AC
301 10.00 AC
50.79 AC
PR#1
PR#2