



T. 6 N., R. 35 E. W. M.

RECEIVED

MAR 23 2000

WATER RESOURCES DEPT.
SALEM, OREGON

Application No. *G 15110*
Permit No.

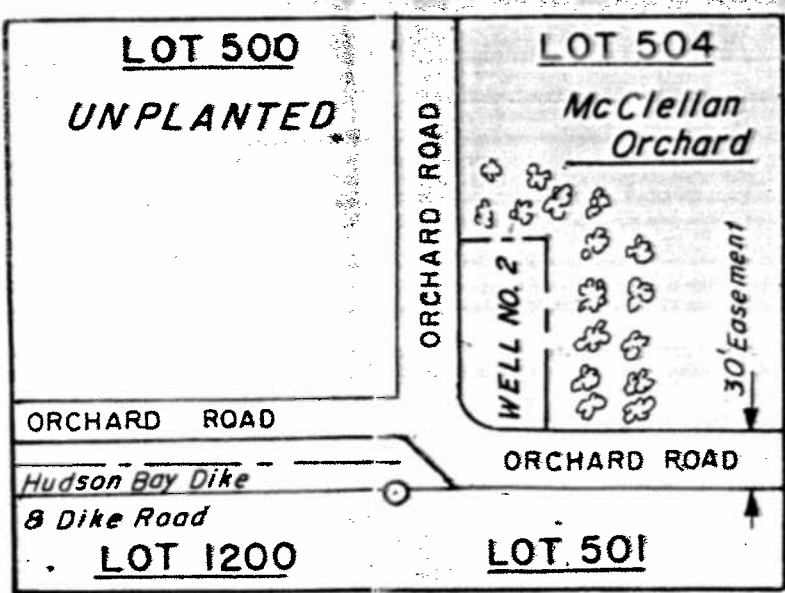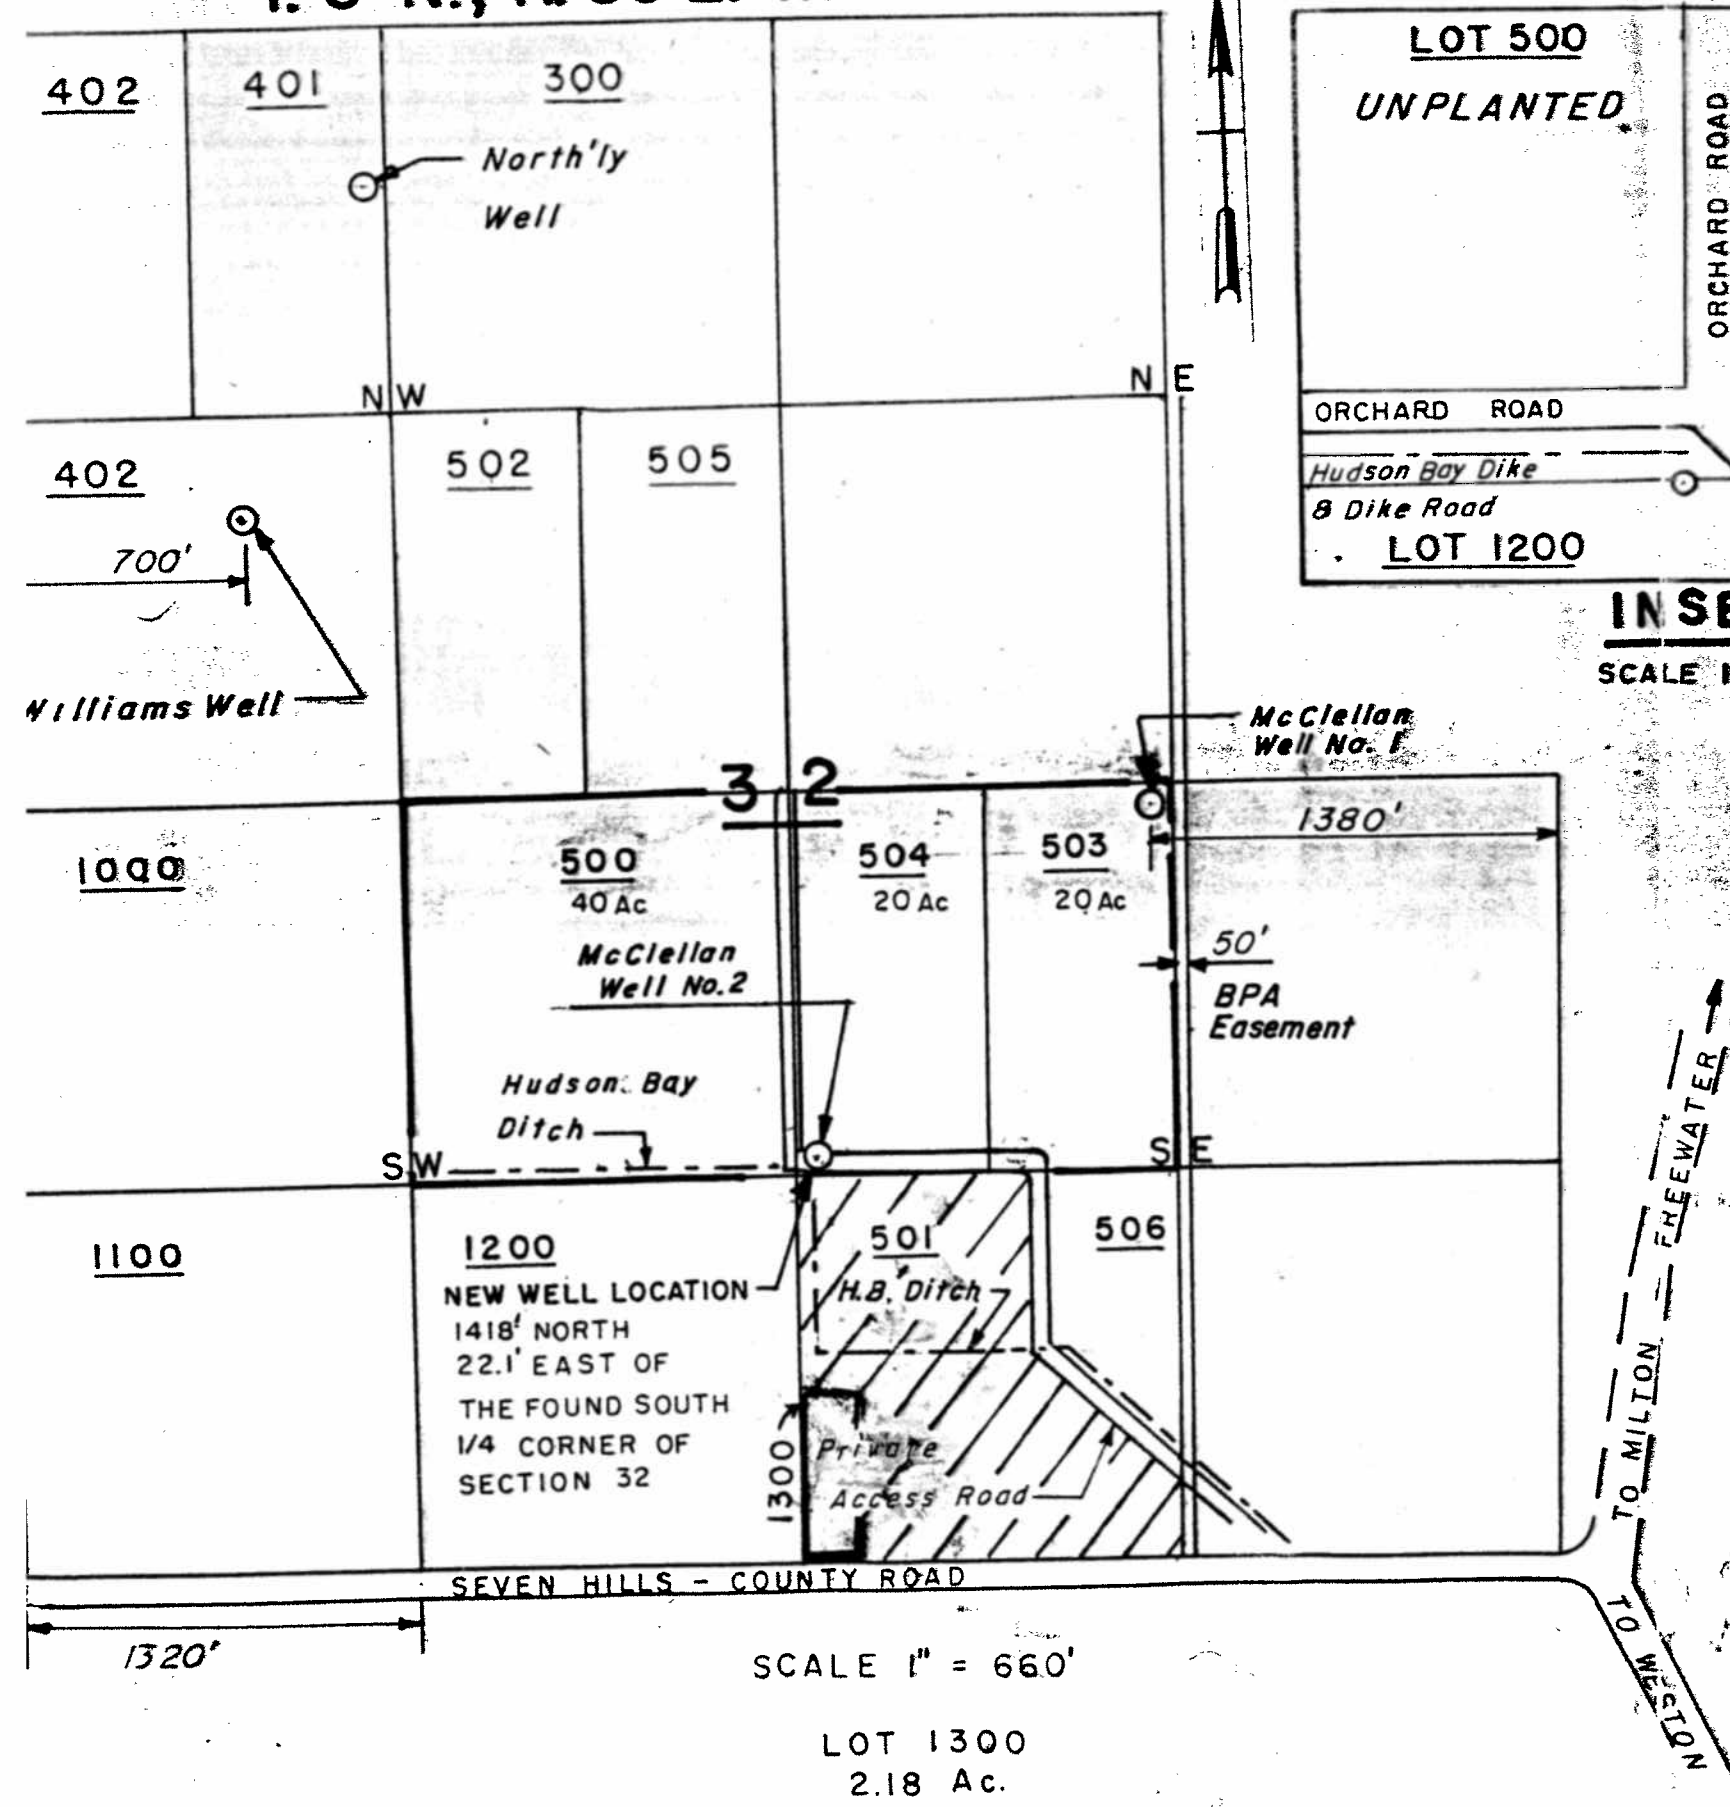

INSET
SCALE 1" = 100'

