SUPERSEDING MAP PER DISCUSSION W/ MALIA KUPILLAS ON 5/16/01 CLARIFYING LETTER RECEIVED 11/2/00 2087

RECEIVED

JAN 07 1999

WATER RESOURCES DEPT.
SALEM, OREGON

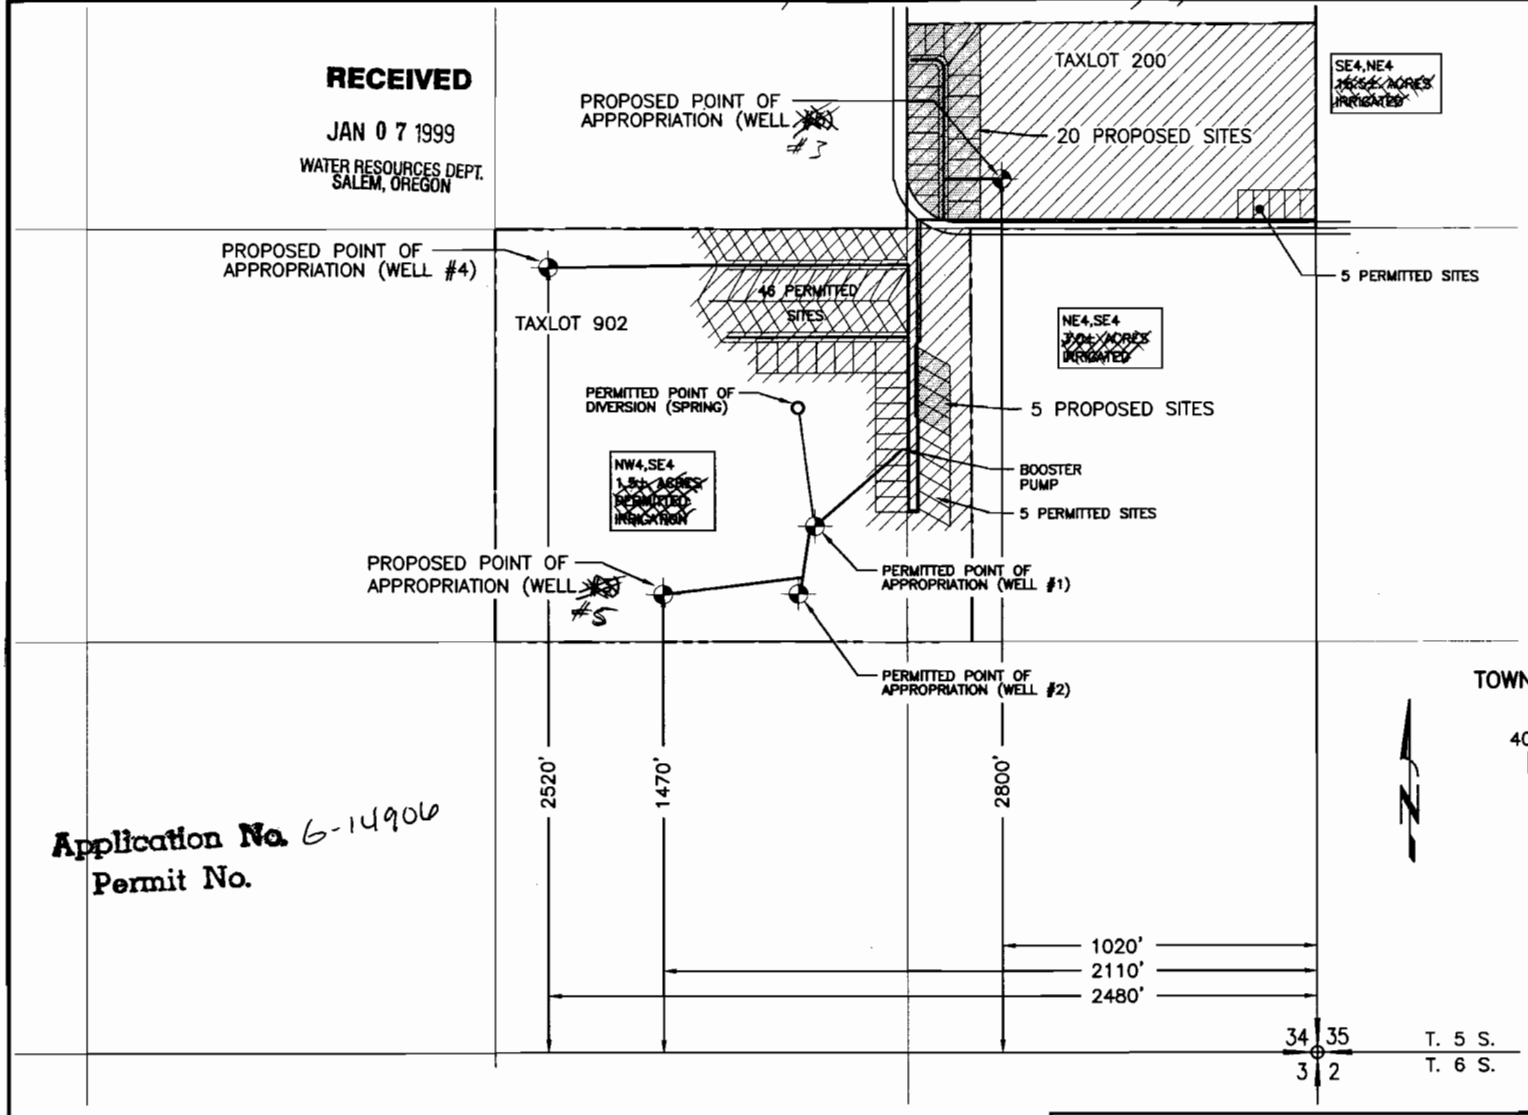

EXPLANATION

- PROPOSED GROUP DOMESTIC USE
- PERMITTED PLACE OF USE UNDER G-14632
- EXISTING SIXTEENTH LINES
- TOTAL IRRIGATED ACRES WITHIN THE SIXTEENTH OF SECTION NOTED
- PROPERTY LINE
- BURIED MAIN WATER LINES

TOWNSHIP 5 SOUTH, RANGE 2 EAST, W.M.

400' 0' 400' 800'

SCALE: 1" = 400'

Application No. G-14906
Permit No.

NOTES:

1. THIS APPLICATION MAP REQUESTS THREE ADDITIONAL PROPOSED WELLS AND A CHANGE IN USE ON THE SE1/4 NE1/4 AND NE1/4 SE1/4 OF SECTION 34 FROM THAT AUTHORIZED BY PERMIT G-13527. THE PROPOSED CHANGE IN USE WOULD ALLOW DEVELOPMENT OF 25 MORE MOBILE-HOME SITES BY REDUCING THE IRRIGATED AREA.
2. THIS MAP WAS PREPARED FOR THE PURPOSE OF IDENTIFYING THE LOCATION OF WATER RIGHT ONLY AND IS NOT INTENDED TO PROVIDE LEGAL DIMENSIONS OR LOCATIONS OF PROPERTY OWNERSHIP LINES.

DAVID J. NEWTON ASSOCIATES, INC.
CIVIL & GEOLOGICAL ENGINEERING SERVICES
1201 S.W. 12TH AVENUE, SUITE 400
PORTLAND, OREGON 97205
(503) 228-7718
FAX (503) 228-7781

Water-Right Application Map

DATE	FILE NAME	PLOT FILE	INITIALS	PROJECT NO.
OCT. 1998	WAT-RT	DNA-256	TIW	743-102

Forest Haven Mobile Park
Clackamas County, Oregon

FIGURE 1