T. 4S., R. 1W., W.M.

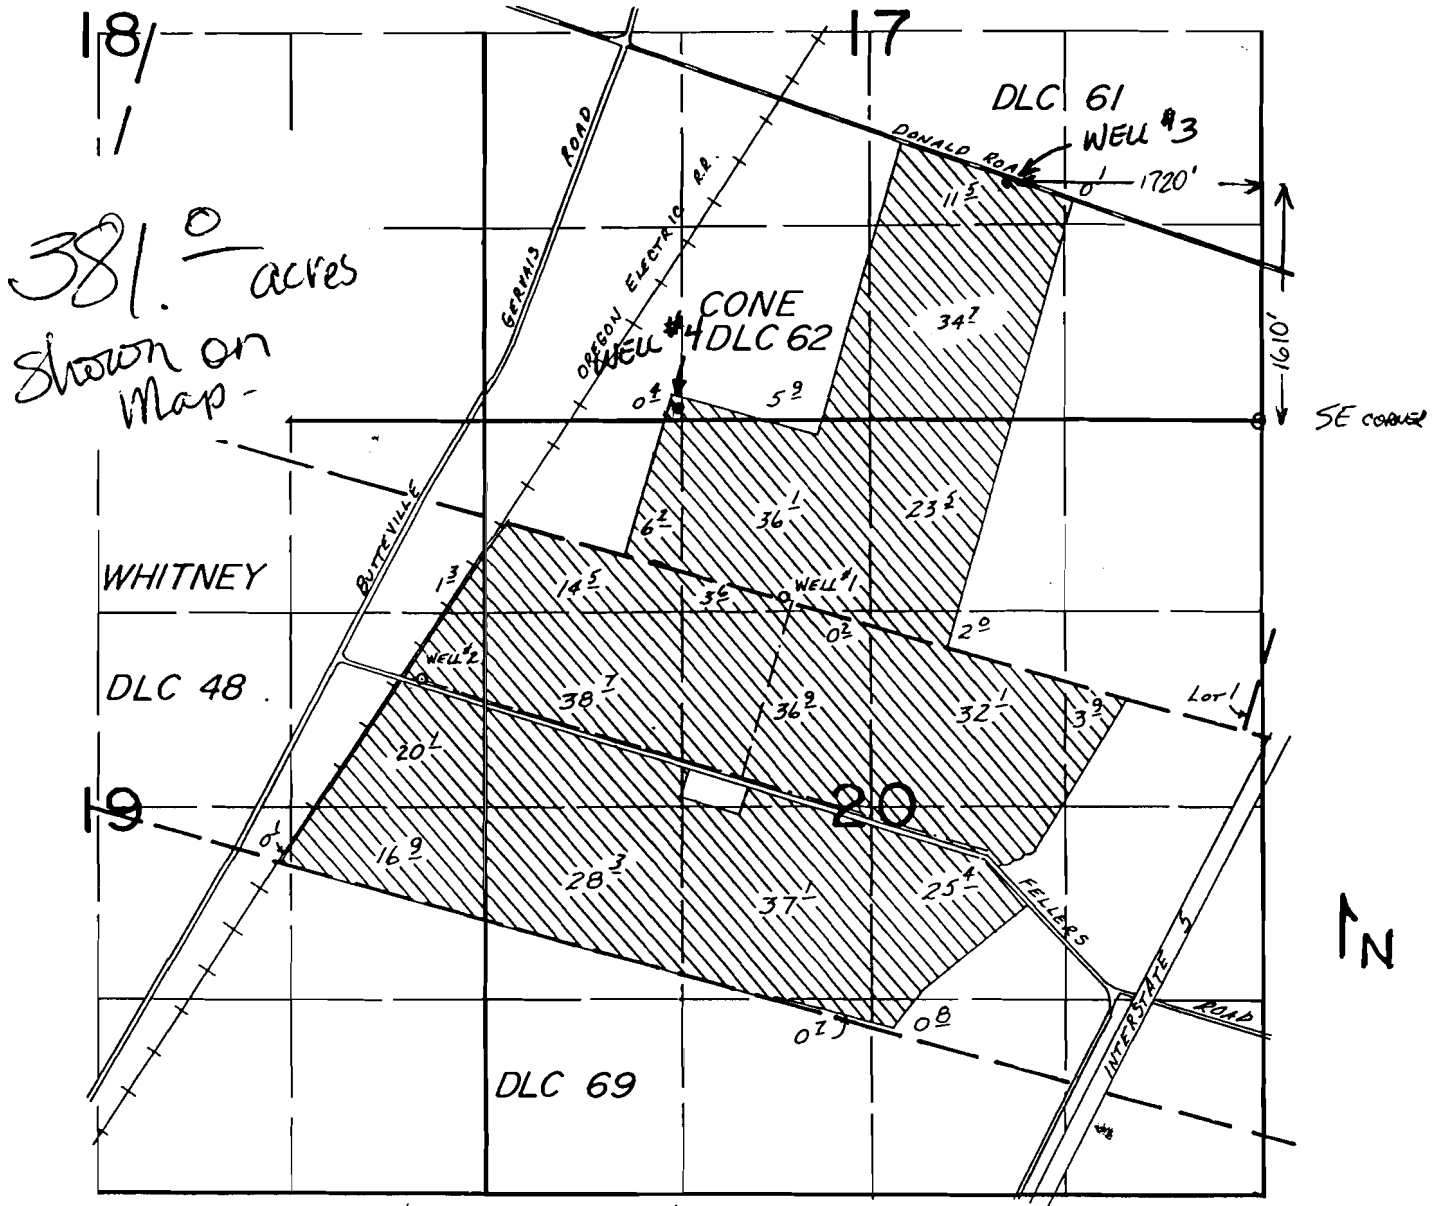

WELLS LOC: #1- 900'N. & 3150'W., #2- 370'N. & 5620'W., BOTH FROM SE COR. CONE DLC 62.

WELL #3 LOCATED 1610' NORTH & 1720' WEST FROM SE COR. SECTION 17

WELL #4 LOCATED 75' NORTH & 3965' WEST FROM SE COR. SECTION 17

FINAL PROOF SURVEY

UNDER

SCALE 1" = 1320'

Application No. G-9124 G-10015 Permit No. G-8443 G-9150

IN NAME OF

NORMAN REILING

Surveyed Sept. 29 1983, by L. M. TOLL

Application No. G 15294
Permit No.

RECEIVED
JAN 18 2001
WATER RESOURCES DEPT
SALEM, OR

DFN-1LL-51 BWB