


WELL LOCATION LYING

IN

SECT. 3 T 5 S R 1 W

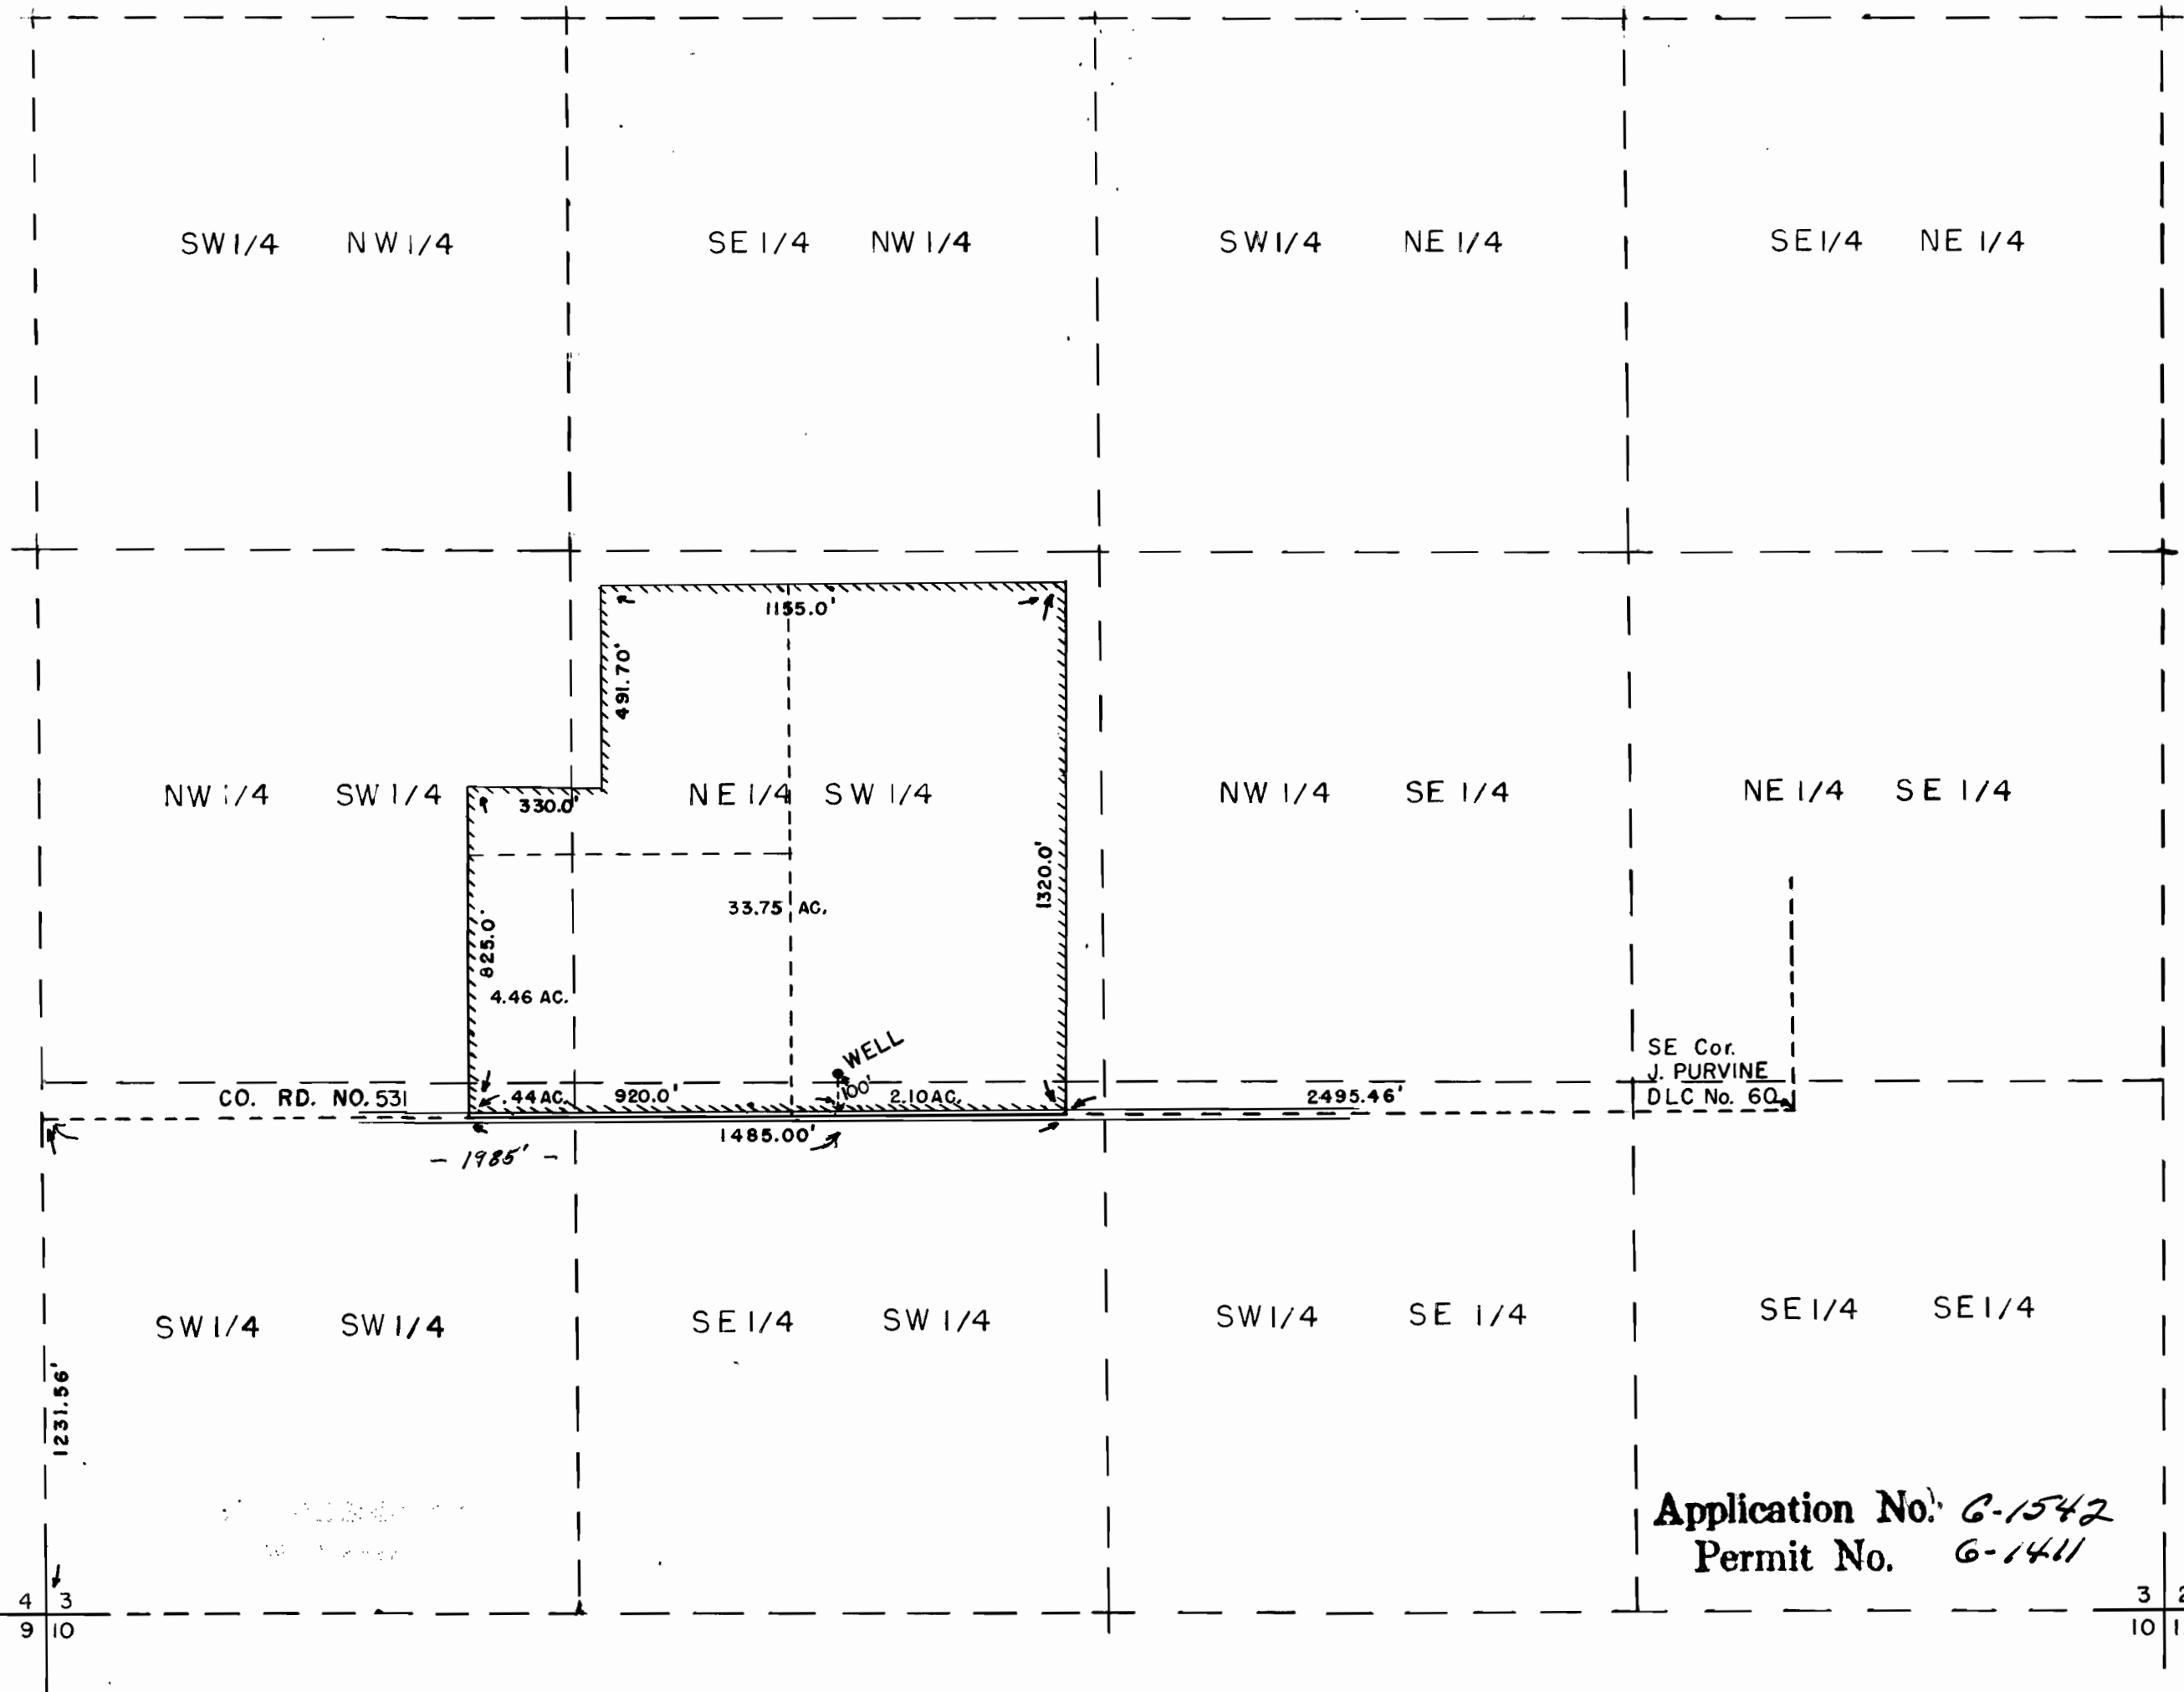

Scale: 1" = 400'

Application No: G-1542
Permit No. G-1411