


# TWP 36 S R7WWM

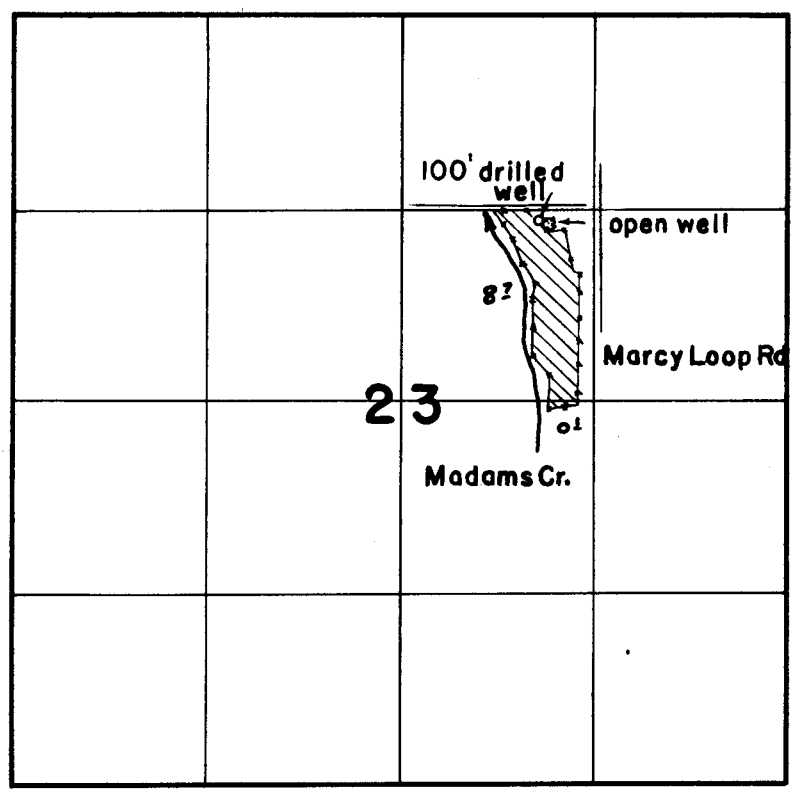

## FINAL PROOF SURVEY UNDER

Application No. G-1543... Permit No. G-1412...  
IN NAME OF

..... Derek A. Pearson .....

Surveyed 6-6..... 1962, by R. Steimer.....