


TWP 38 S R 5 W W M

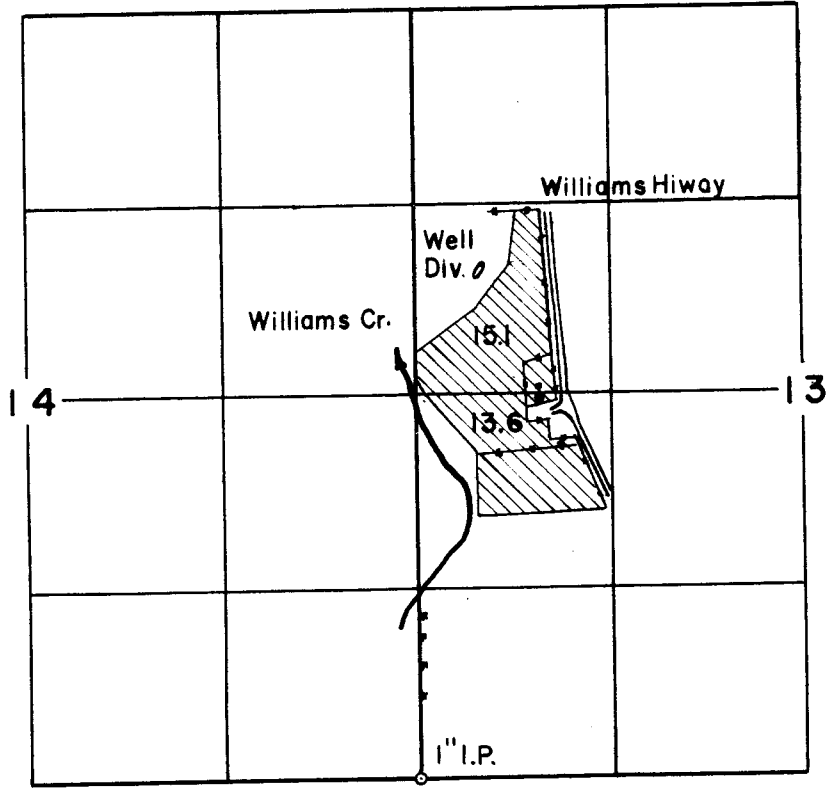

**FINAL PROOF SURVEY**  
UNDER

Application No. G-1552 Permit No. G-1416  
IN NAME OF

Robert E. Thomas

Surveyed 10-25 1961, by Steimer