

W.R. 704

C.S. 1658


C. R. MC CORMICK

SEC. 35, T. 11 S., R. 2 W.

APRIL 7, 1942 SCALE: 1" = 100'

WALTER W. LARSEN
COUNTY SURVEYOR

Survey by V. G. Shelton
Dep. Co. Surveyor

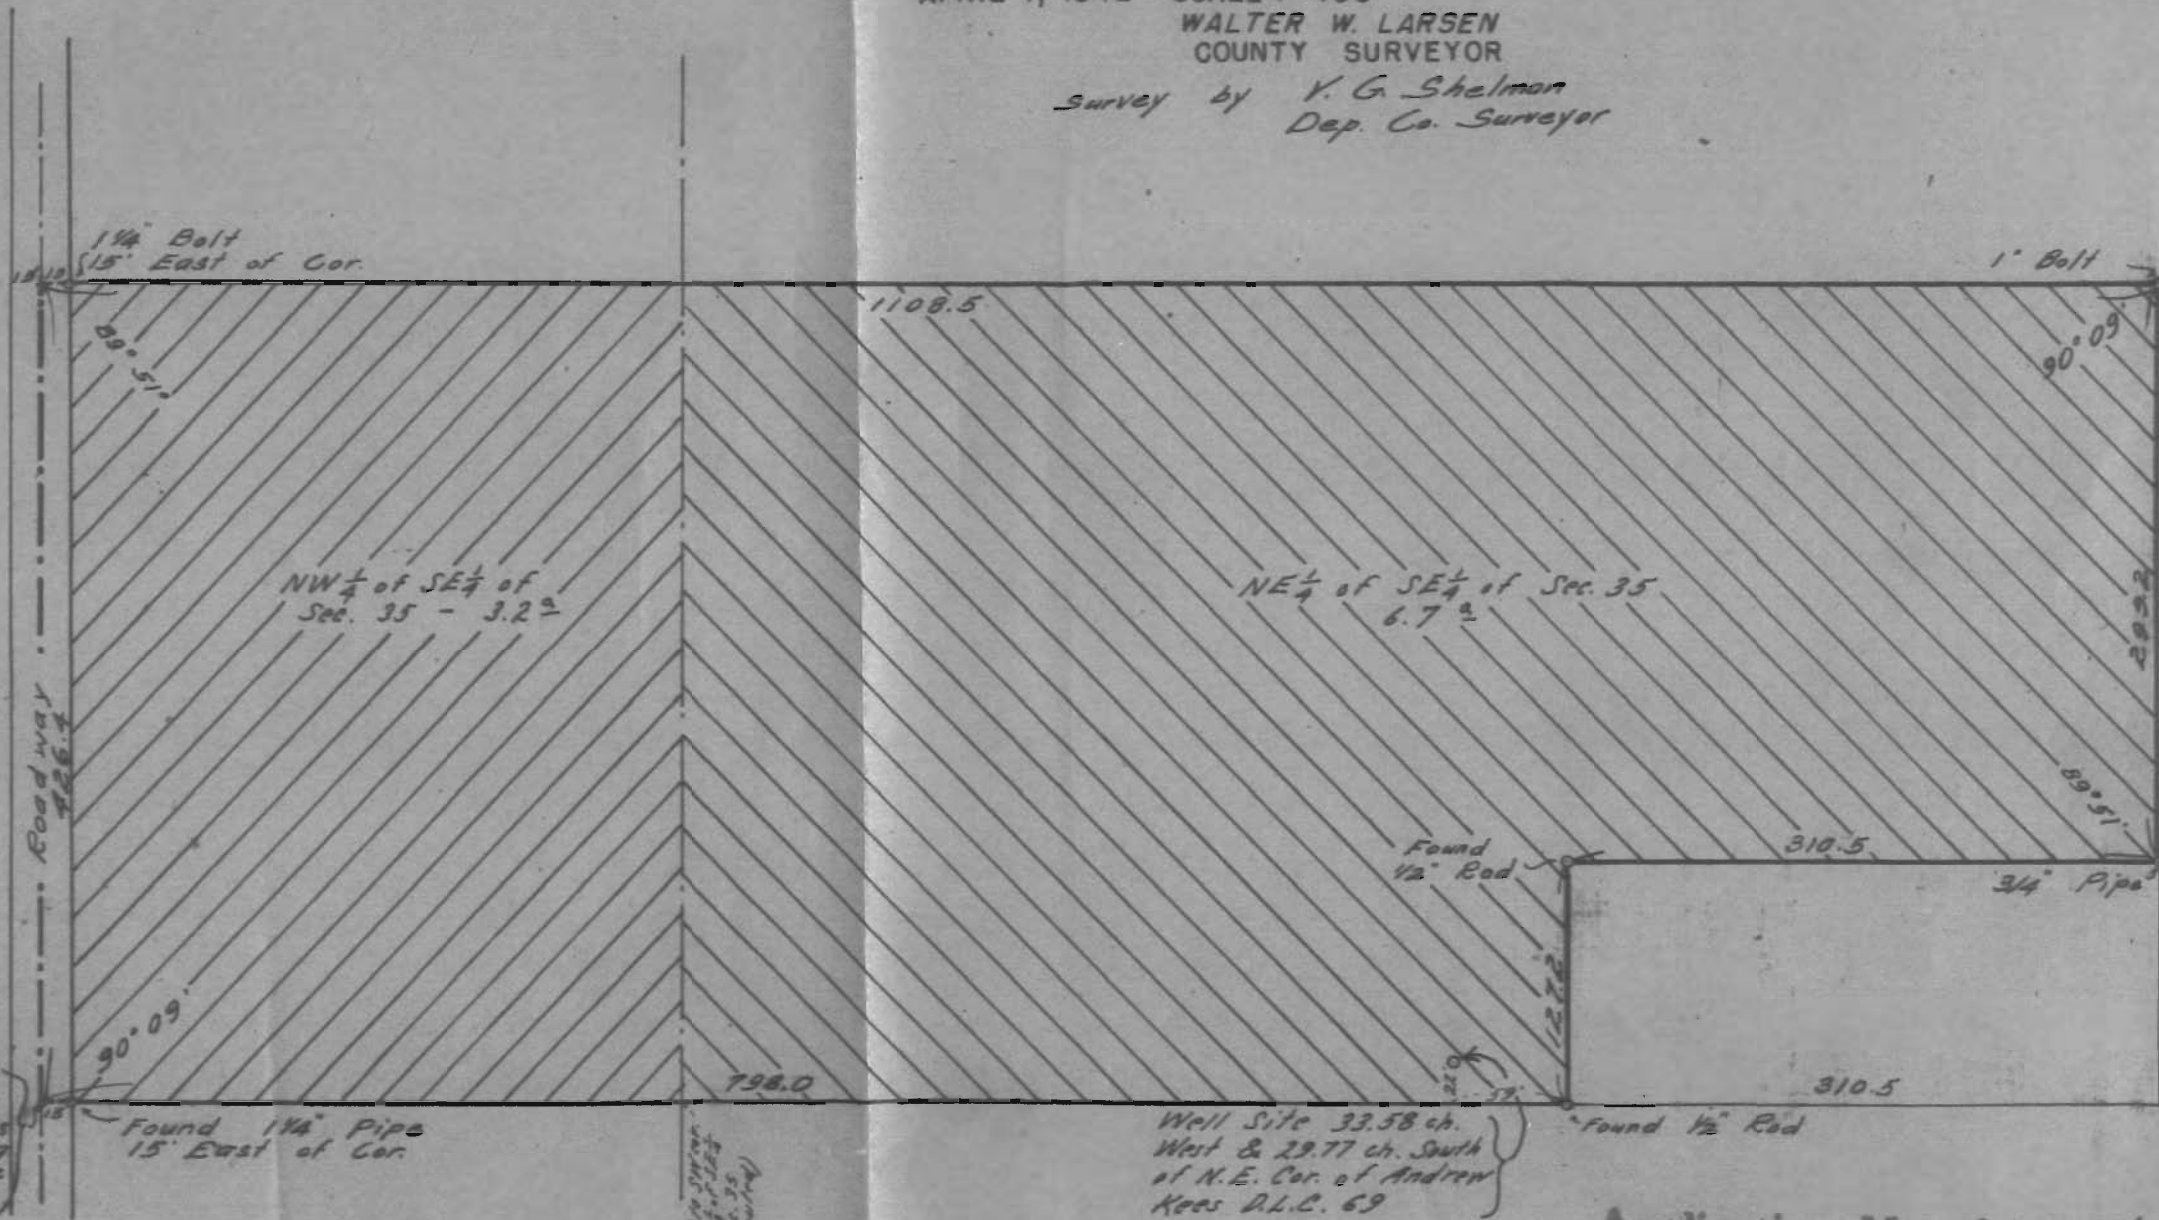

Application No. G-1558
Permit No. G-1429