


Oregon

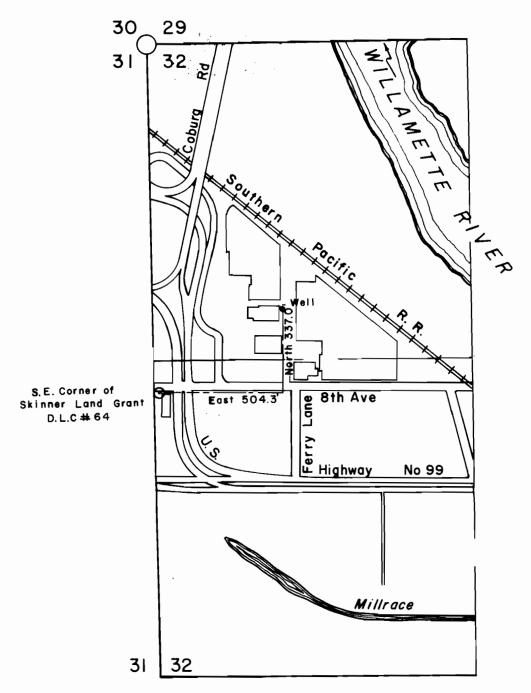

TI7S R3W

Prepared for EUGENE FRUIT GROWERS
ASSOCIATION by the Office of H. G. Chickering Jr.,
Consulting Photogrammetrist Inc., Eugene, Oregon.,
September 16, 1959., from Vertical Aerial Photography
Dated April, 1957.

Application No. G-1555
Permit No. G-1443

SCALE I"= 400

