


R. L. and Wilma Wood

RAW

Application No. G-1570
Permit No. G-1451

T
/
N

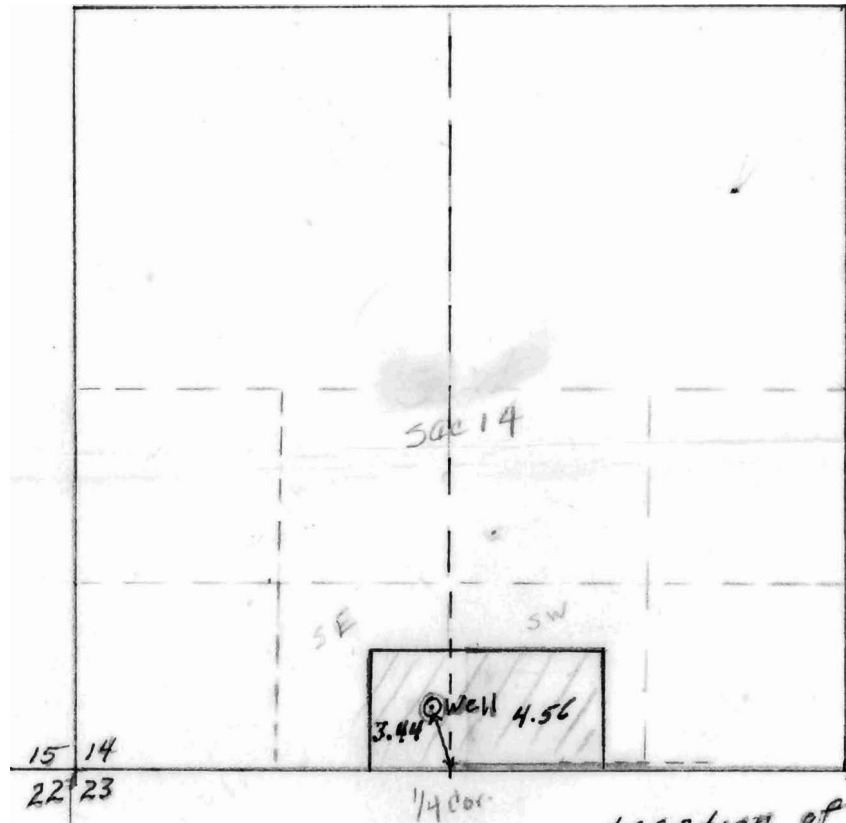

RECEIVED
SEP 1 1959
STATE ENGINEER
SALEM, OREGON
Will irrigate
Total area.

Location of Well
200 # N. 18° 30' W
From 1/4 cor on
S. sec. line