



T. 23 S.,
R. 32 E.,
W. M.
Sec. 28

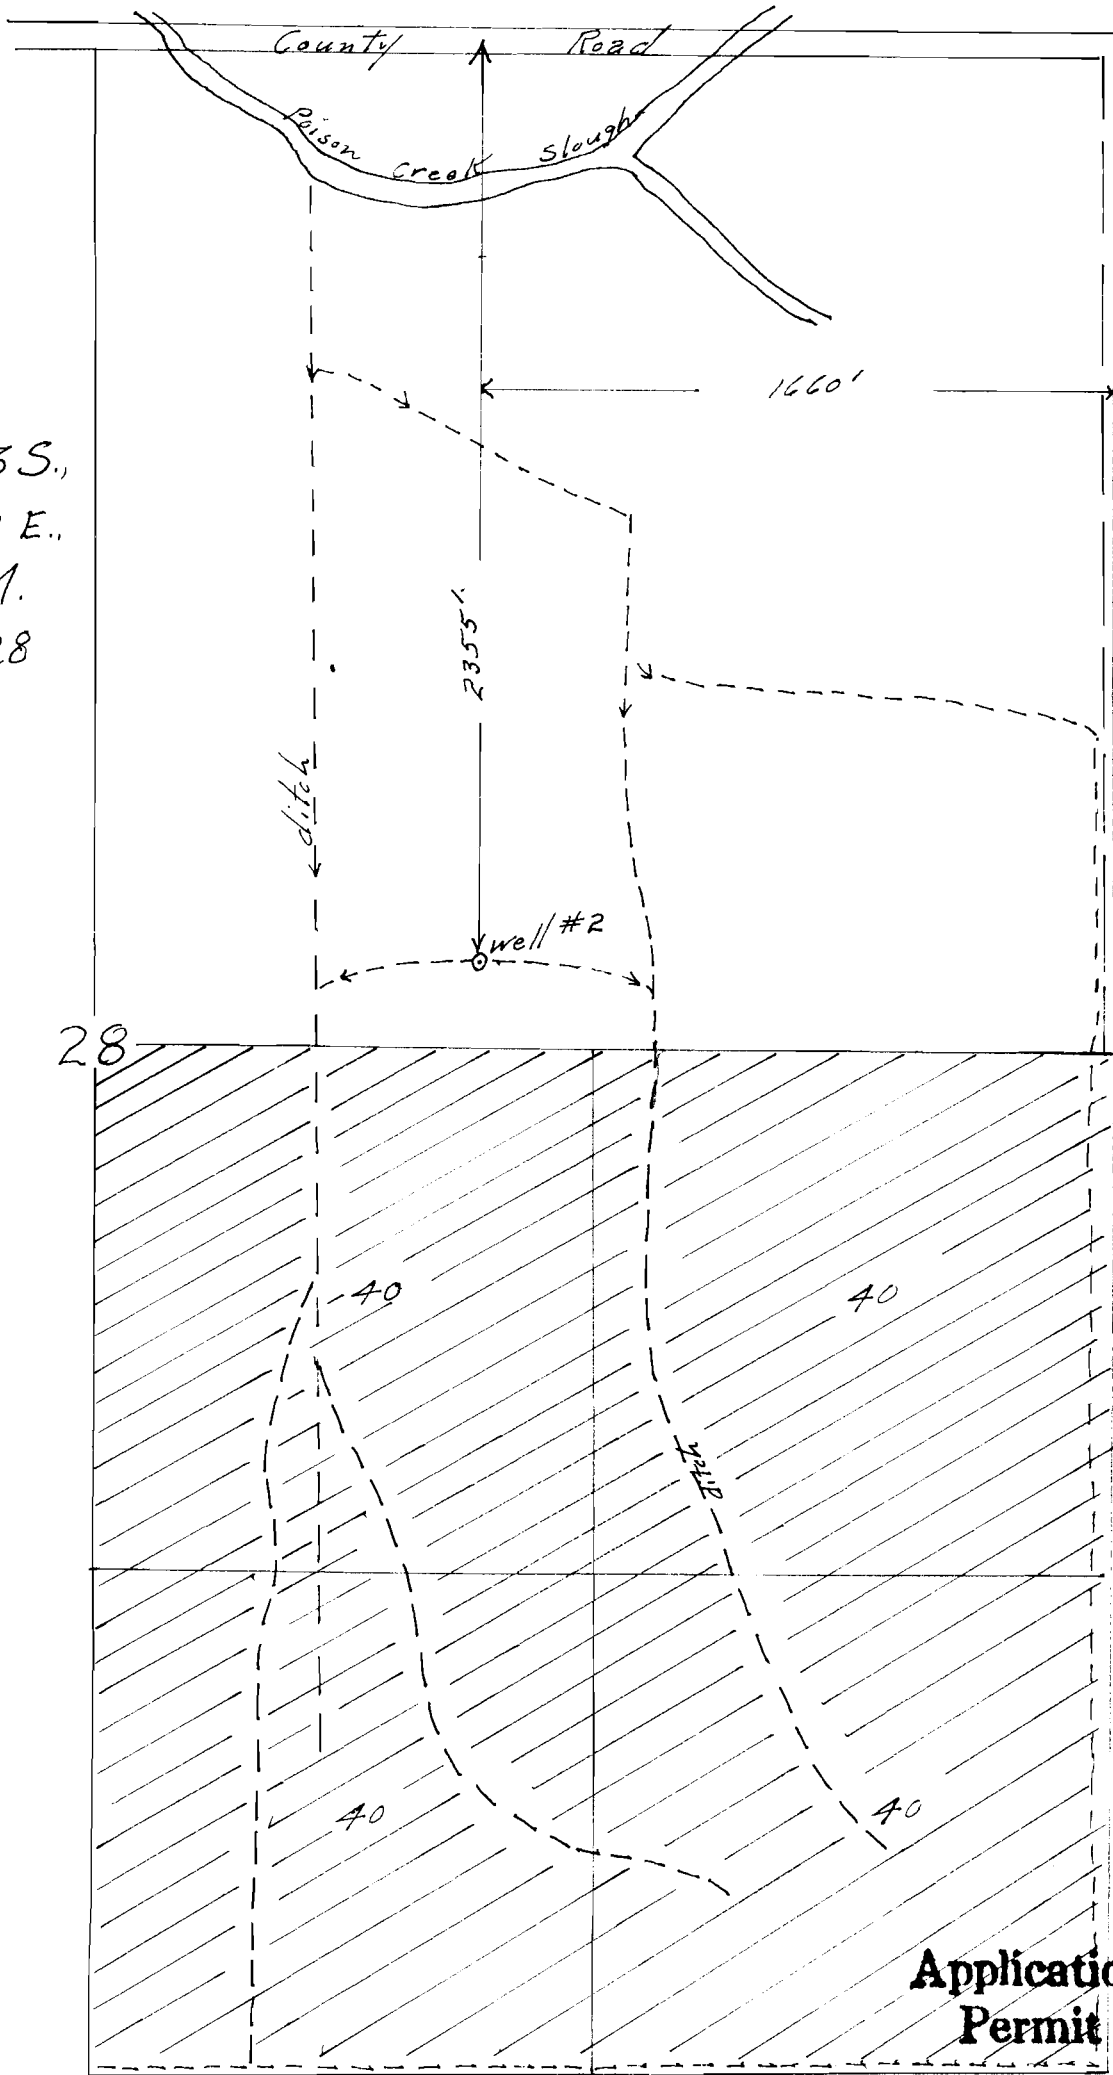

Iron Pipe
31' S & 30' E
From NE Cor
of Sec 28

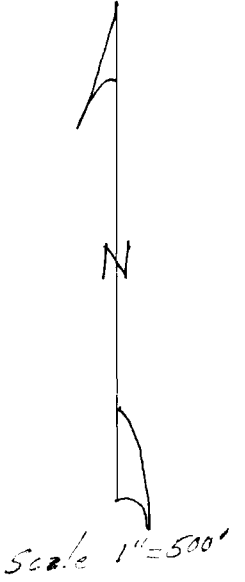

Application No. G-1614
Permit No. G-1484