

This map was prepared for assessment purposes only.

SECTION 11 T5S, R.1W, W.M.
CLAC AMAS COUNTY

JOHN M. BACON D.L.C. NO. 71
JOHN KILLINS D.L.C. NO. 72

5 1W 11


4000

4400

5000

31000

32000

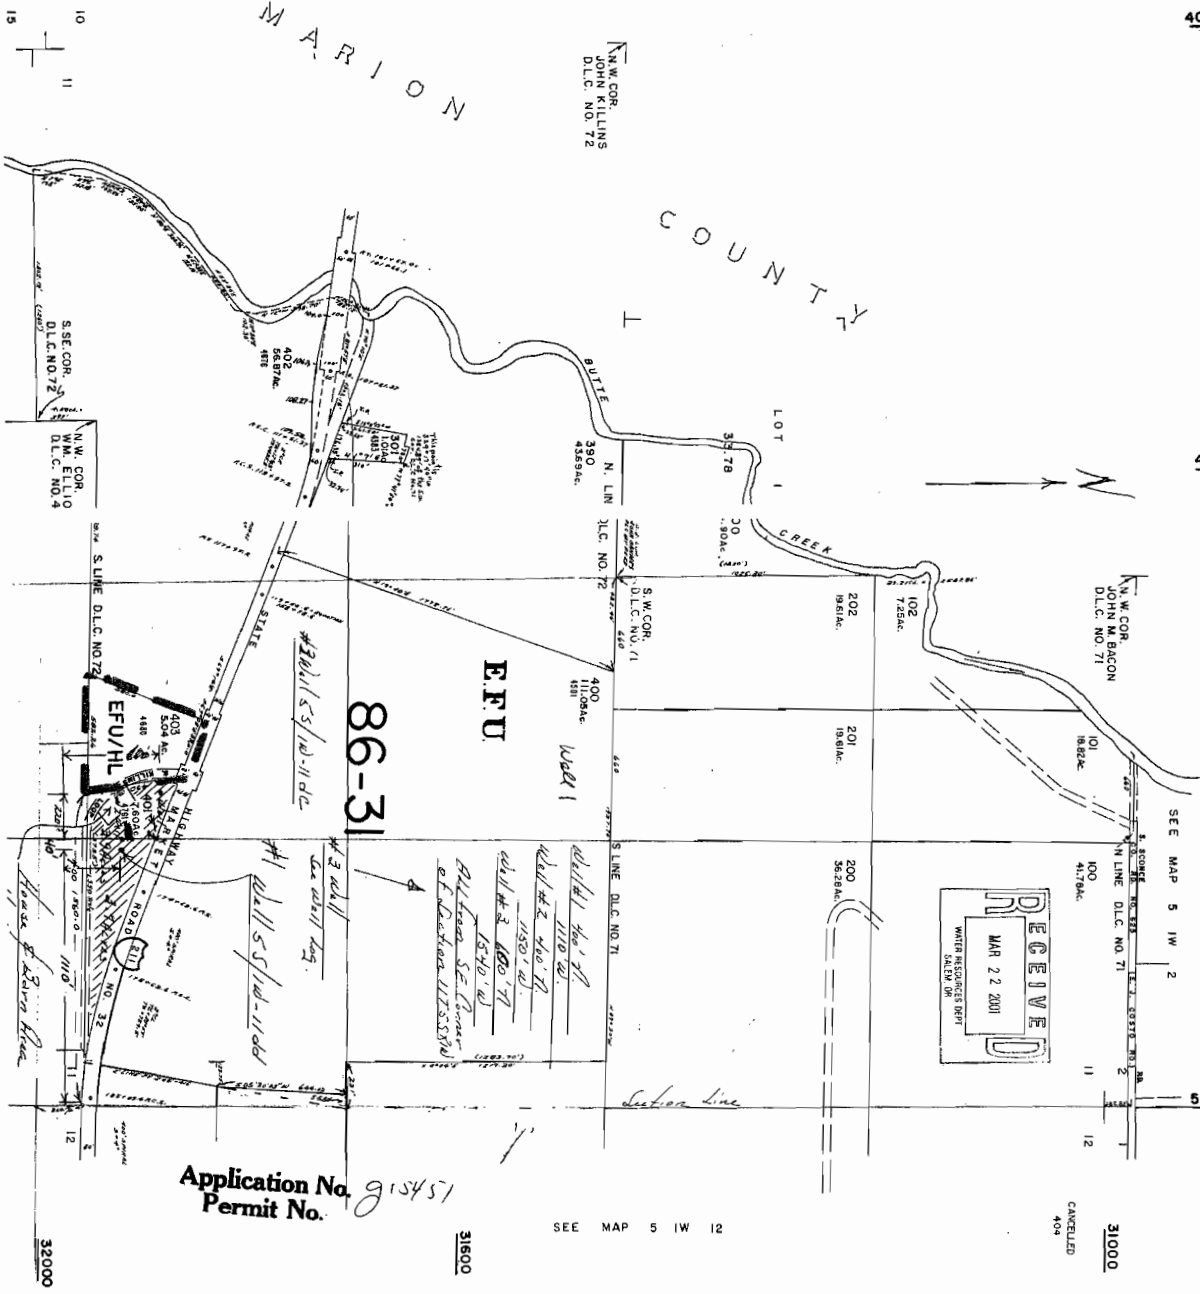

MARION COUNTY

N.W. COR.
JOHN KILLINS
D.L.C. NO. 72

N.W. COR.
JOHN M. BACON
D.L.C. NO. 71

N.W. COR.
WM. ELLIO
D.L.C. NO. 4

S.E. COR.
D.L.C. NO. 72

FFU

86-31

Application No. 91545
Permit No.

SEE MAP 5 1W 12

CANCELLED
404

CANCELLED TAX LOTS
391