


SEE MAP 39 5 6

SEE MAP 39 5 4

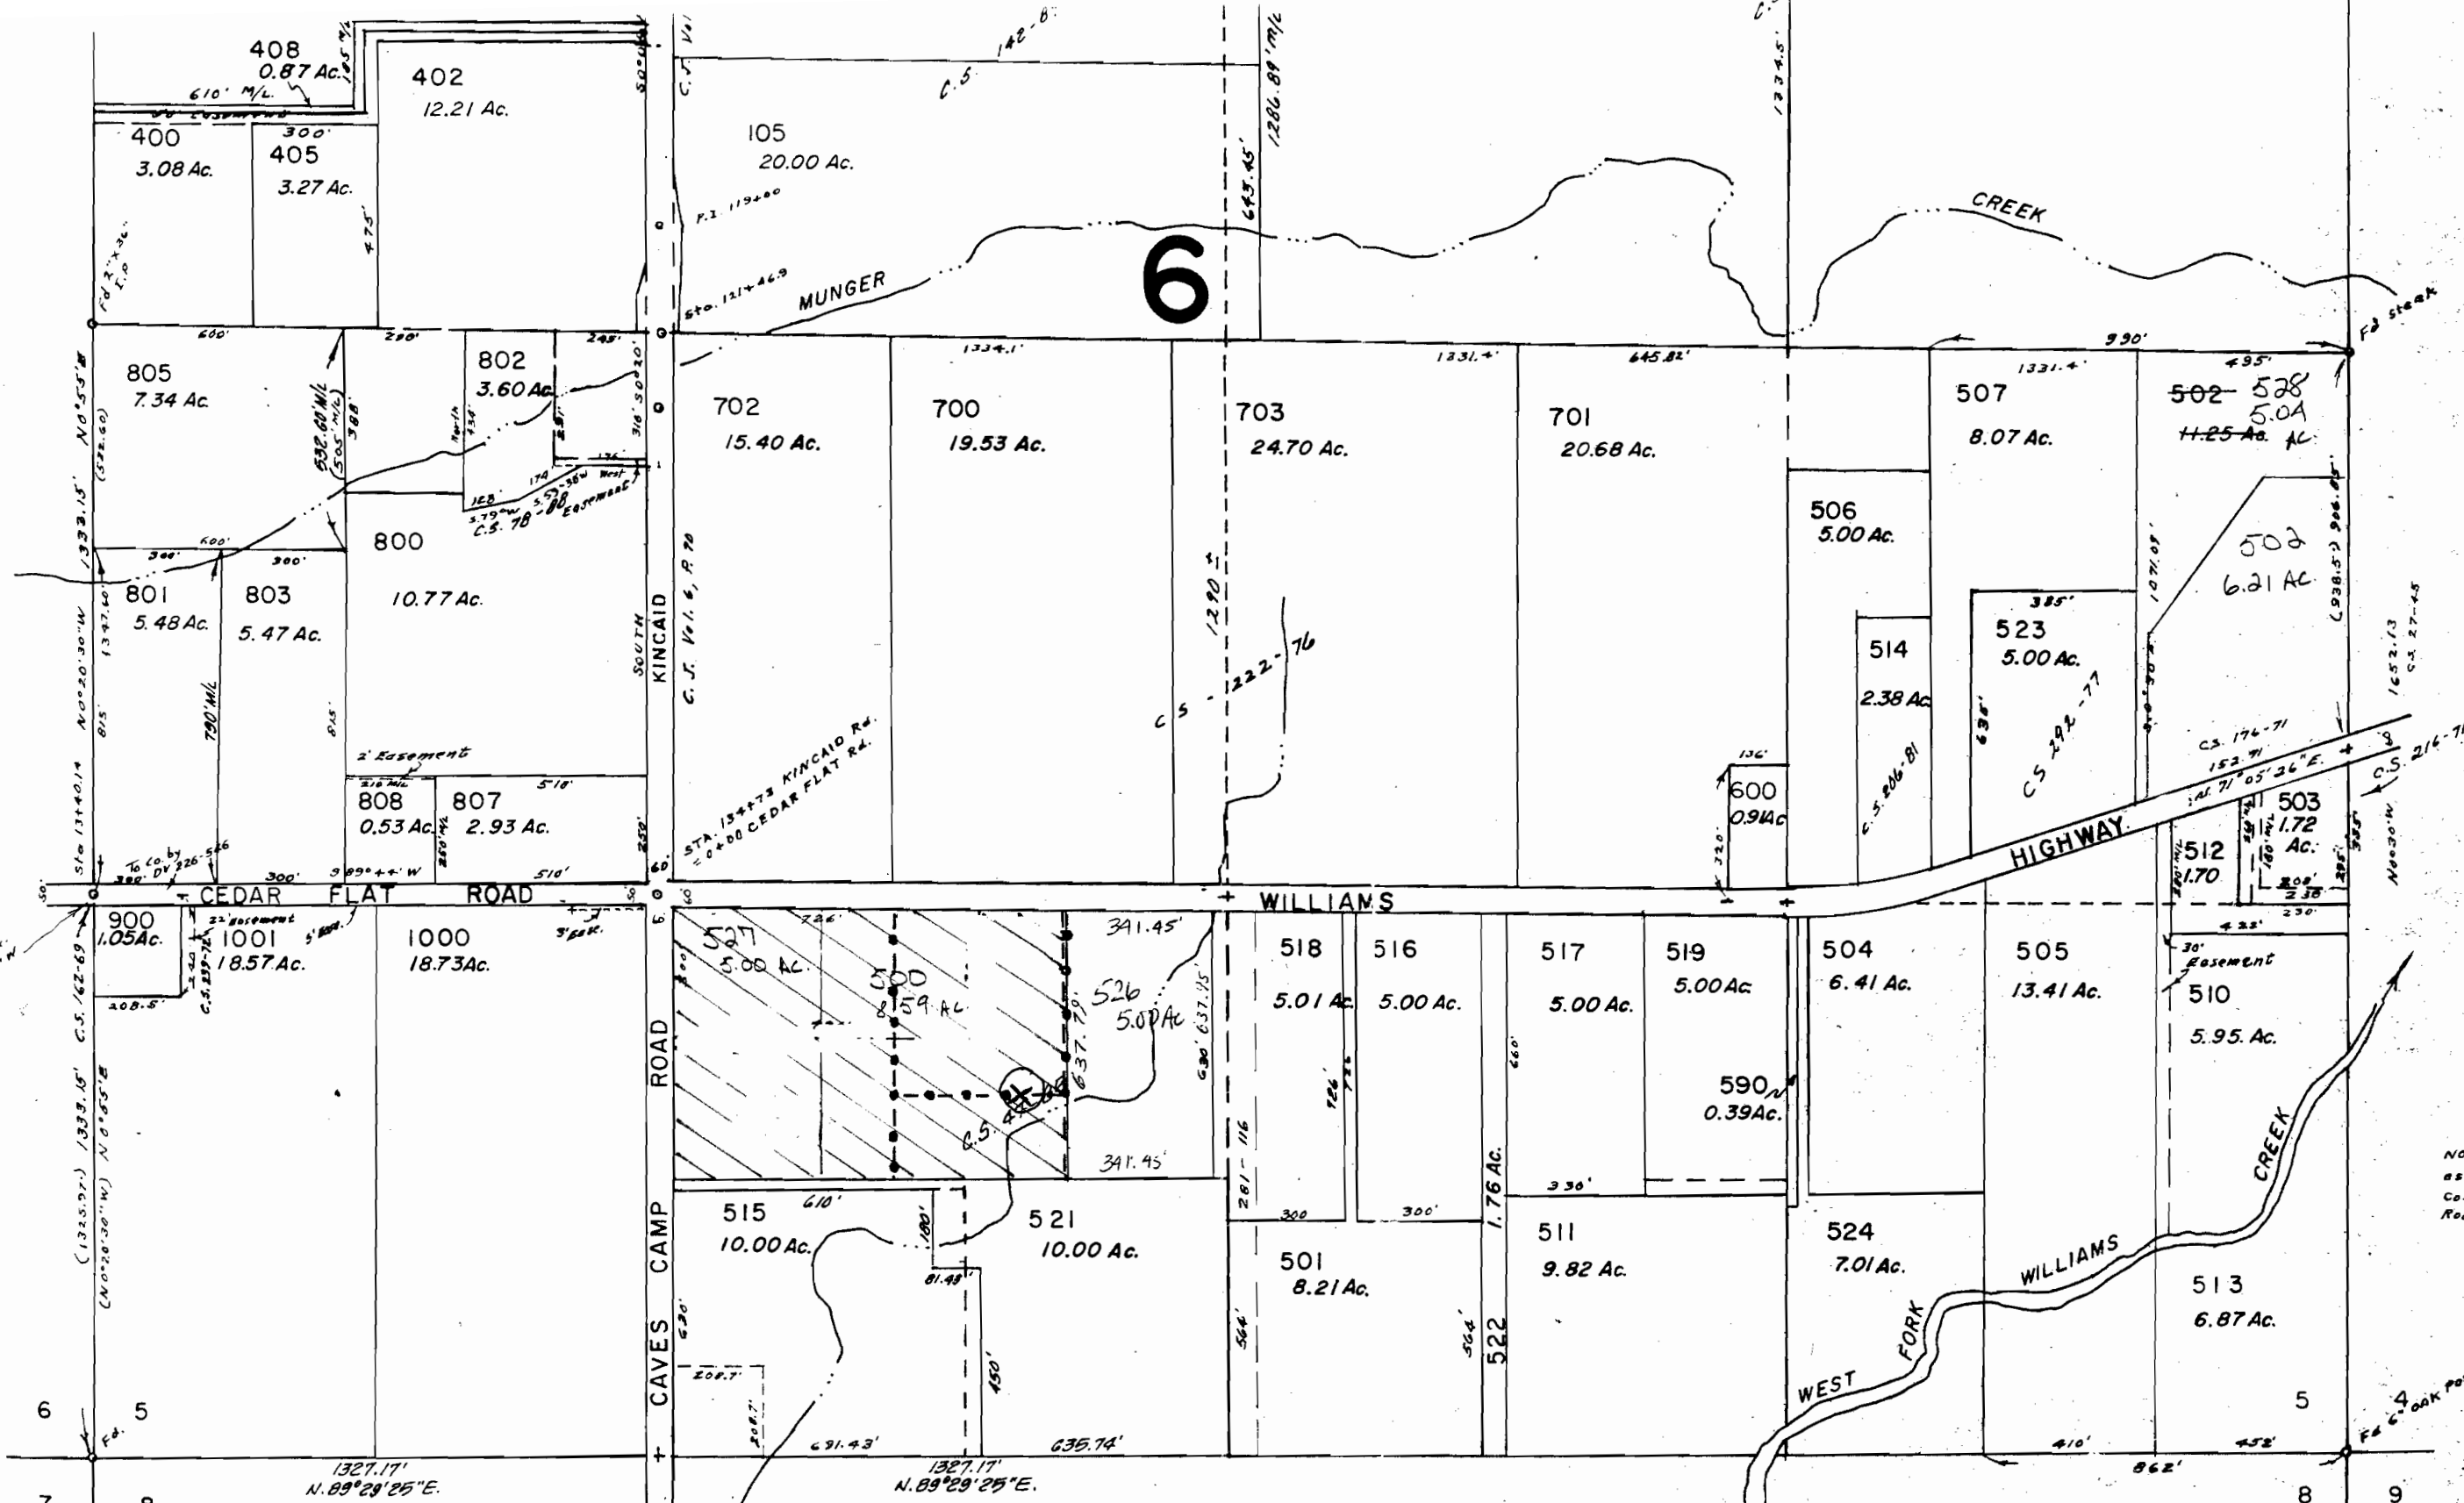

NOTE: SEC. Grid established from Co. Survey & Co. Road Surveys.

Application No. 915253
Permit No.

SCALE 1" = 400'

39S - 5W - 5W.M.

RECEIVED
NOV 15 2000
WATER RESOURCES DEPT.
SALEM, OREGON
SEE MAP 39 5 3

⊗ WELL #1 IN 860' E 2208' FROM SW SECTION CORNER (5)
- - - MAINLINE
▨ PROPOSED AREA OF USE

39 5 3