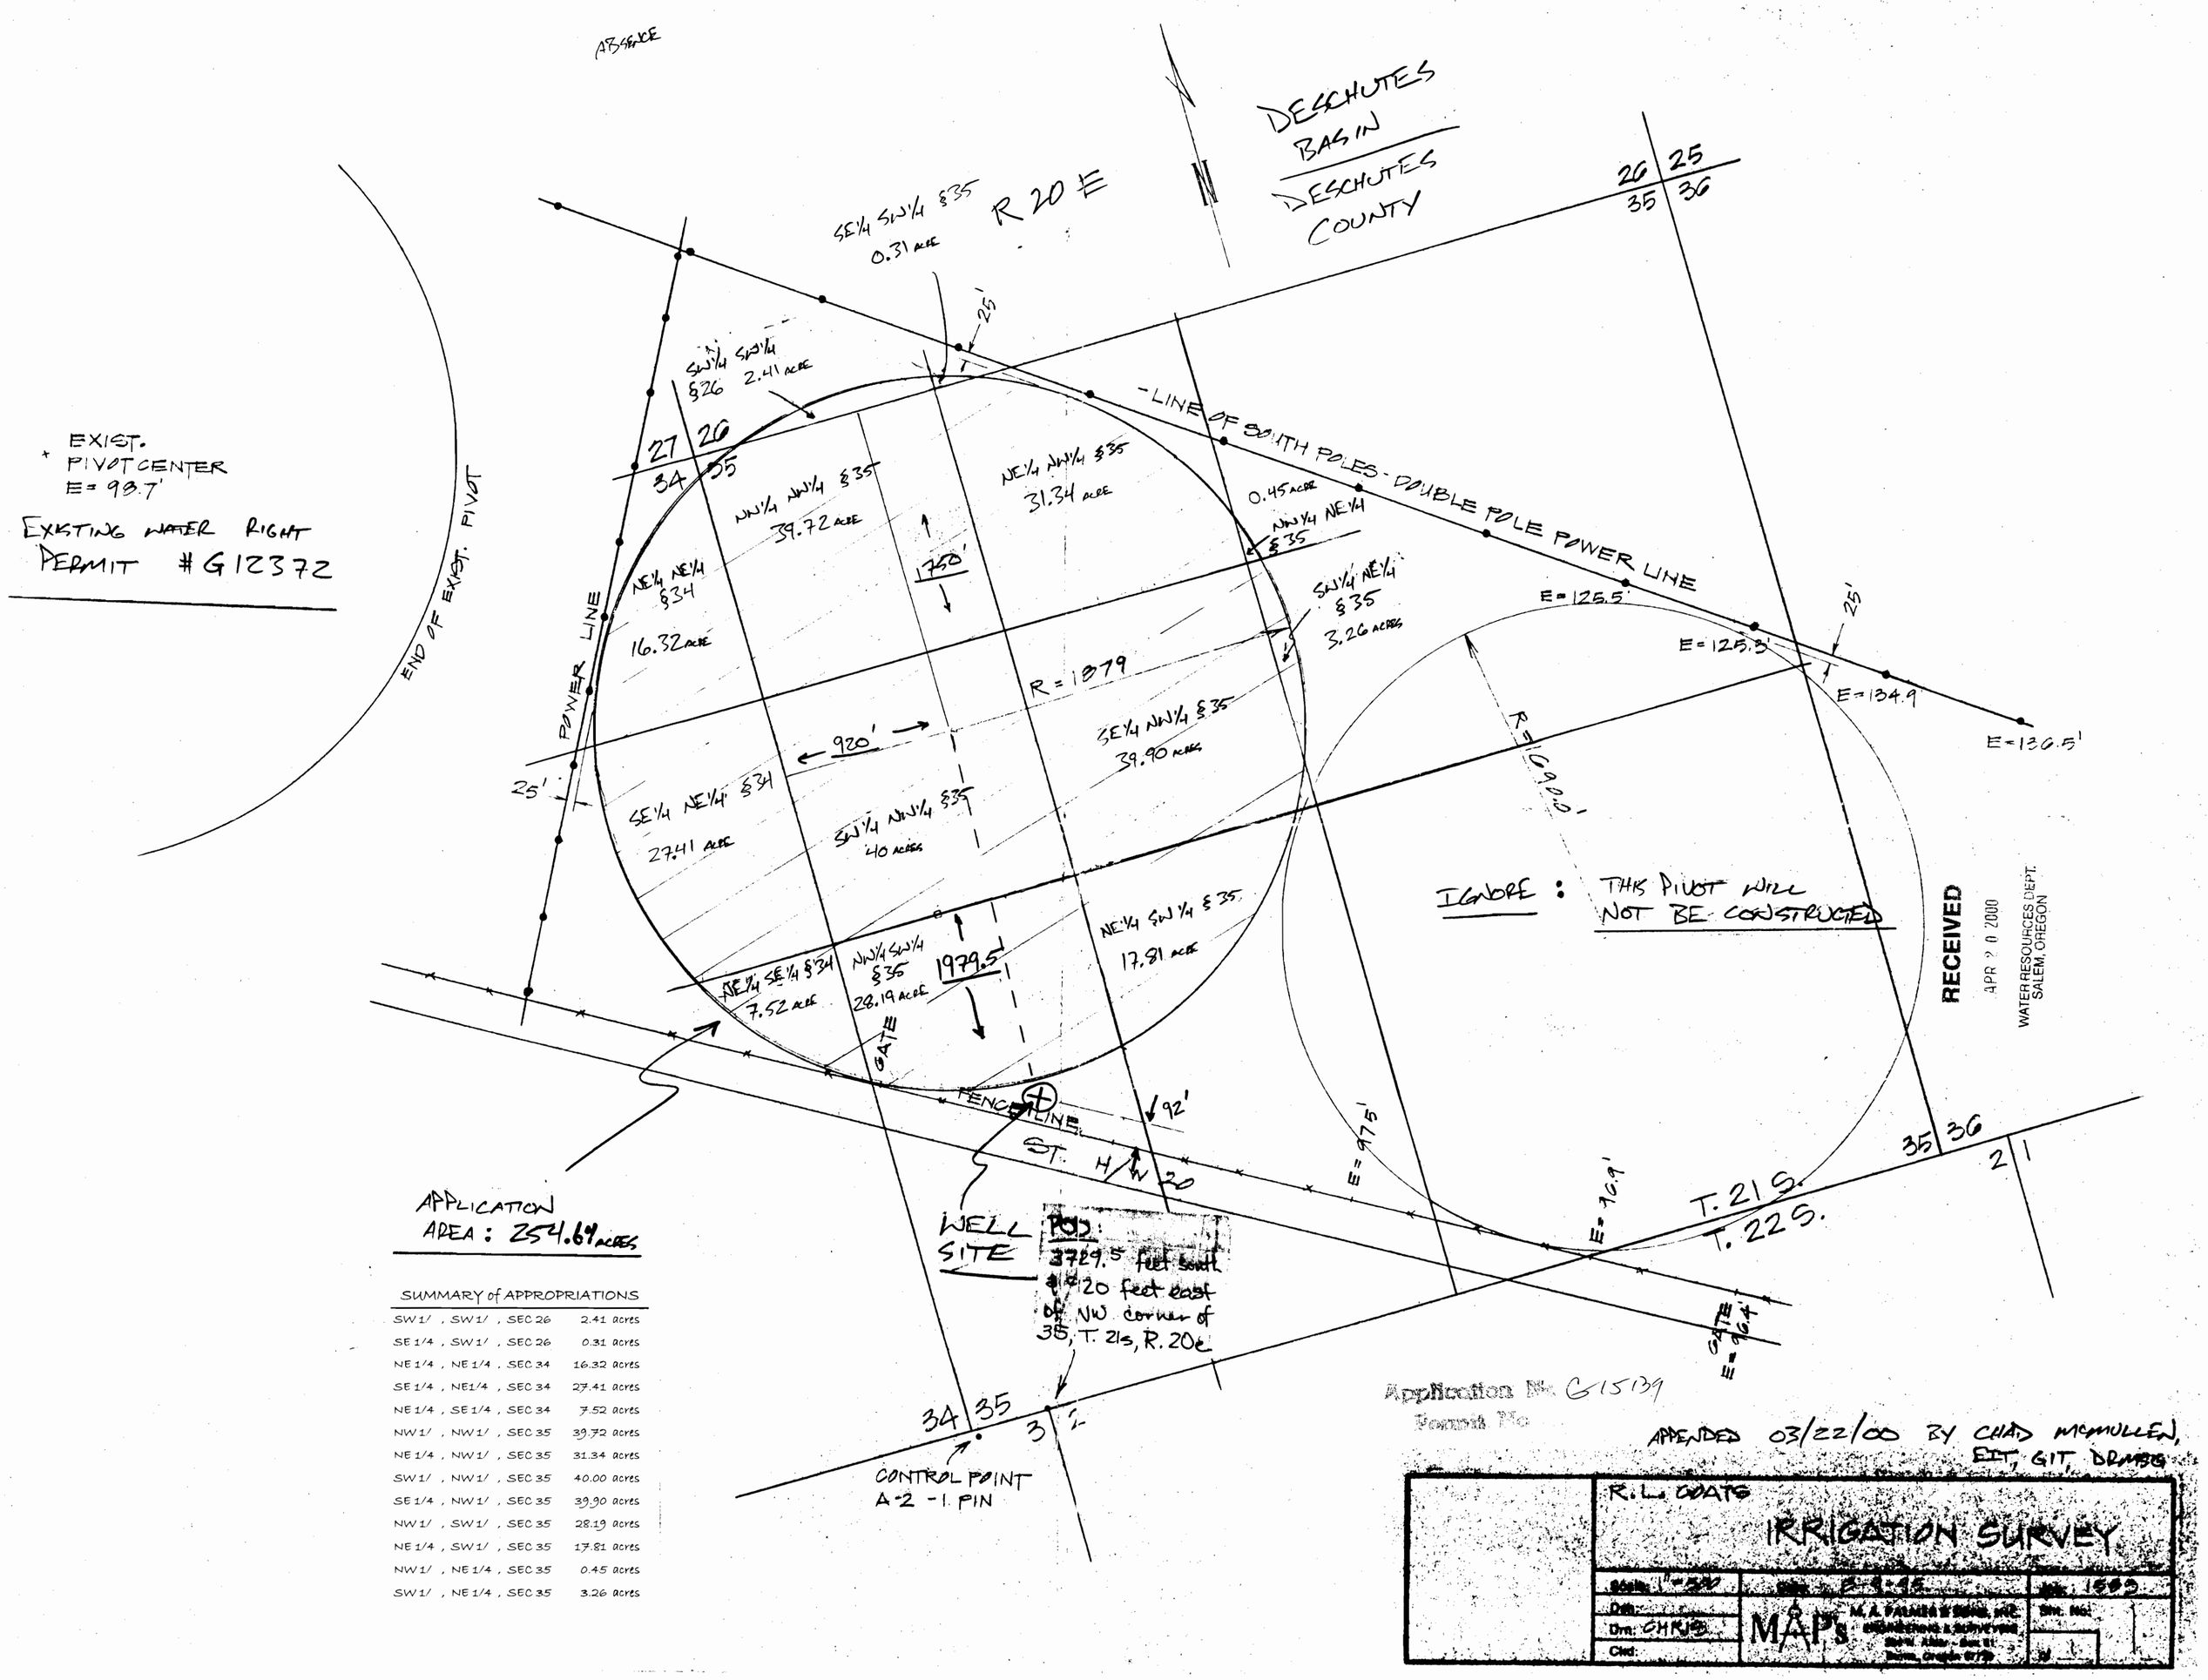

SUMMARY of APPROPRIATIONS

SW1/ , SW1/ , SEC 26	2.41 acres
SE 1/4 , SW1/ , SEC 26	0.31 acres
NE 1/4 , NE 1/4 , SEC 34	16.32 acres
SE 1/4 , NE1/4 , SEC 34	27.41 acres
NE 1/4 , SE 1/4 , SEC 34	7.52 acres
NW1/ , NW1/ , SEC 35	39.72 acres
NE 1/4 , NW1/ , SEC 35	31.34 acres
SW1/ , NW1/ , SEC 35	40.00 acres
SE 1/4 , NW1/ , SEC 35	39.90 acres
NW1/ , SW1/ , SEC 35	28.19 acres
NE 1/4 , SW1/ , SEC 35	17.81 acres
NW1/ , NE 1/4 , SEC 35	0.45 acres
SW1/ , NE 1/4 , SEC 35	3.26 acres

RECEIVED
APR 20 2000
WATER RESOURCES DEPT.
SALEM, OREGON

Application No. G15139
Permit No.

APPENDED 03/22/00 BY CHAD McMULLEN, EIT, GIT, DRMSG

R. L. COATS

IRRIGATION SURVEY

Scale: 1"=500	Date: 8-9-95	Job: 1589
Dwn:	MAP's M. A. PALMER & SONS, INC. ENGINEERING & SURVEYING	Sht. No:
Drn: CHRIS		
Ckd:		