


NOTE - THIS AREA ASSESSED WITH TAX LOT 400 ON MAP 06-1W-07

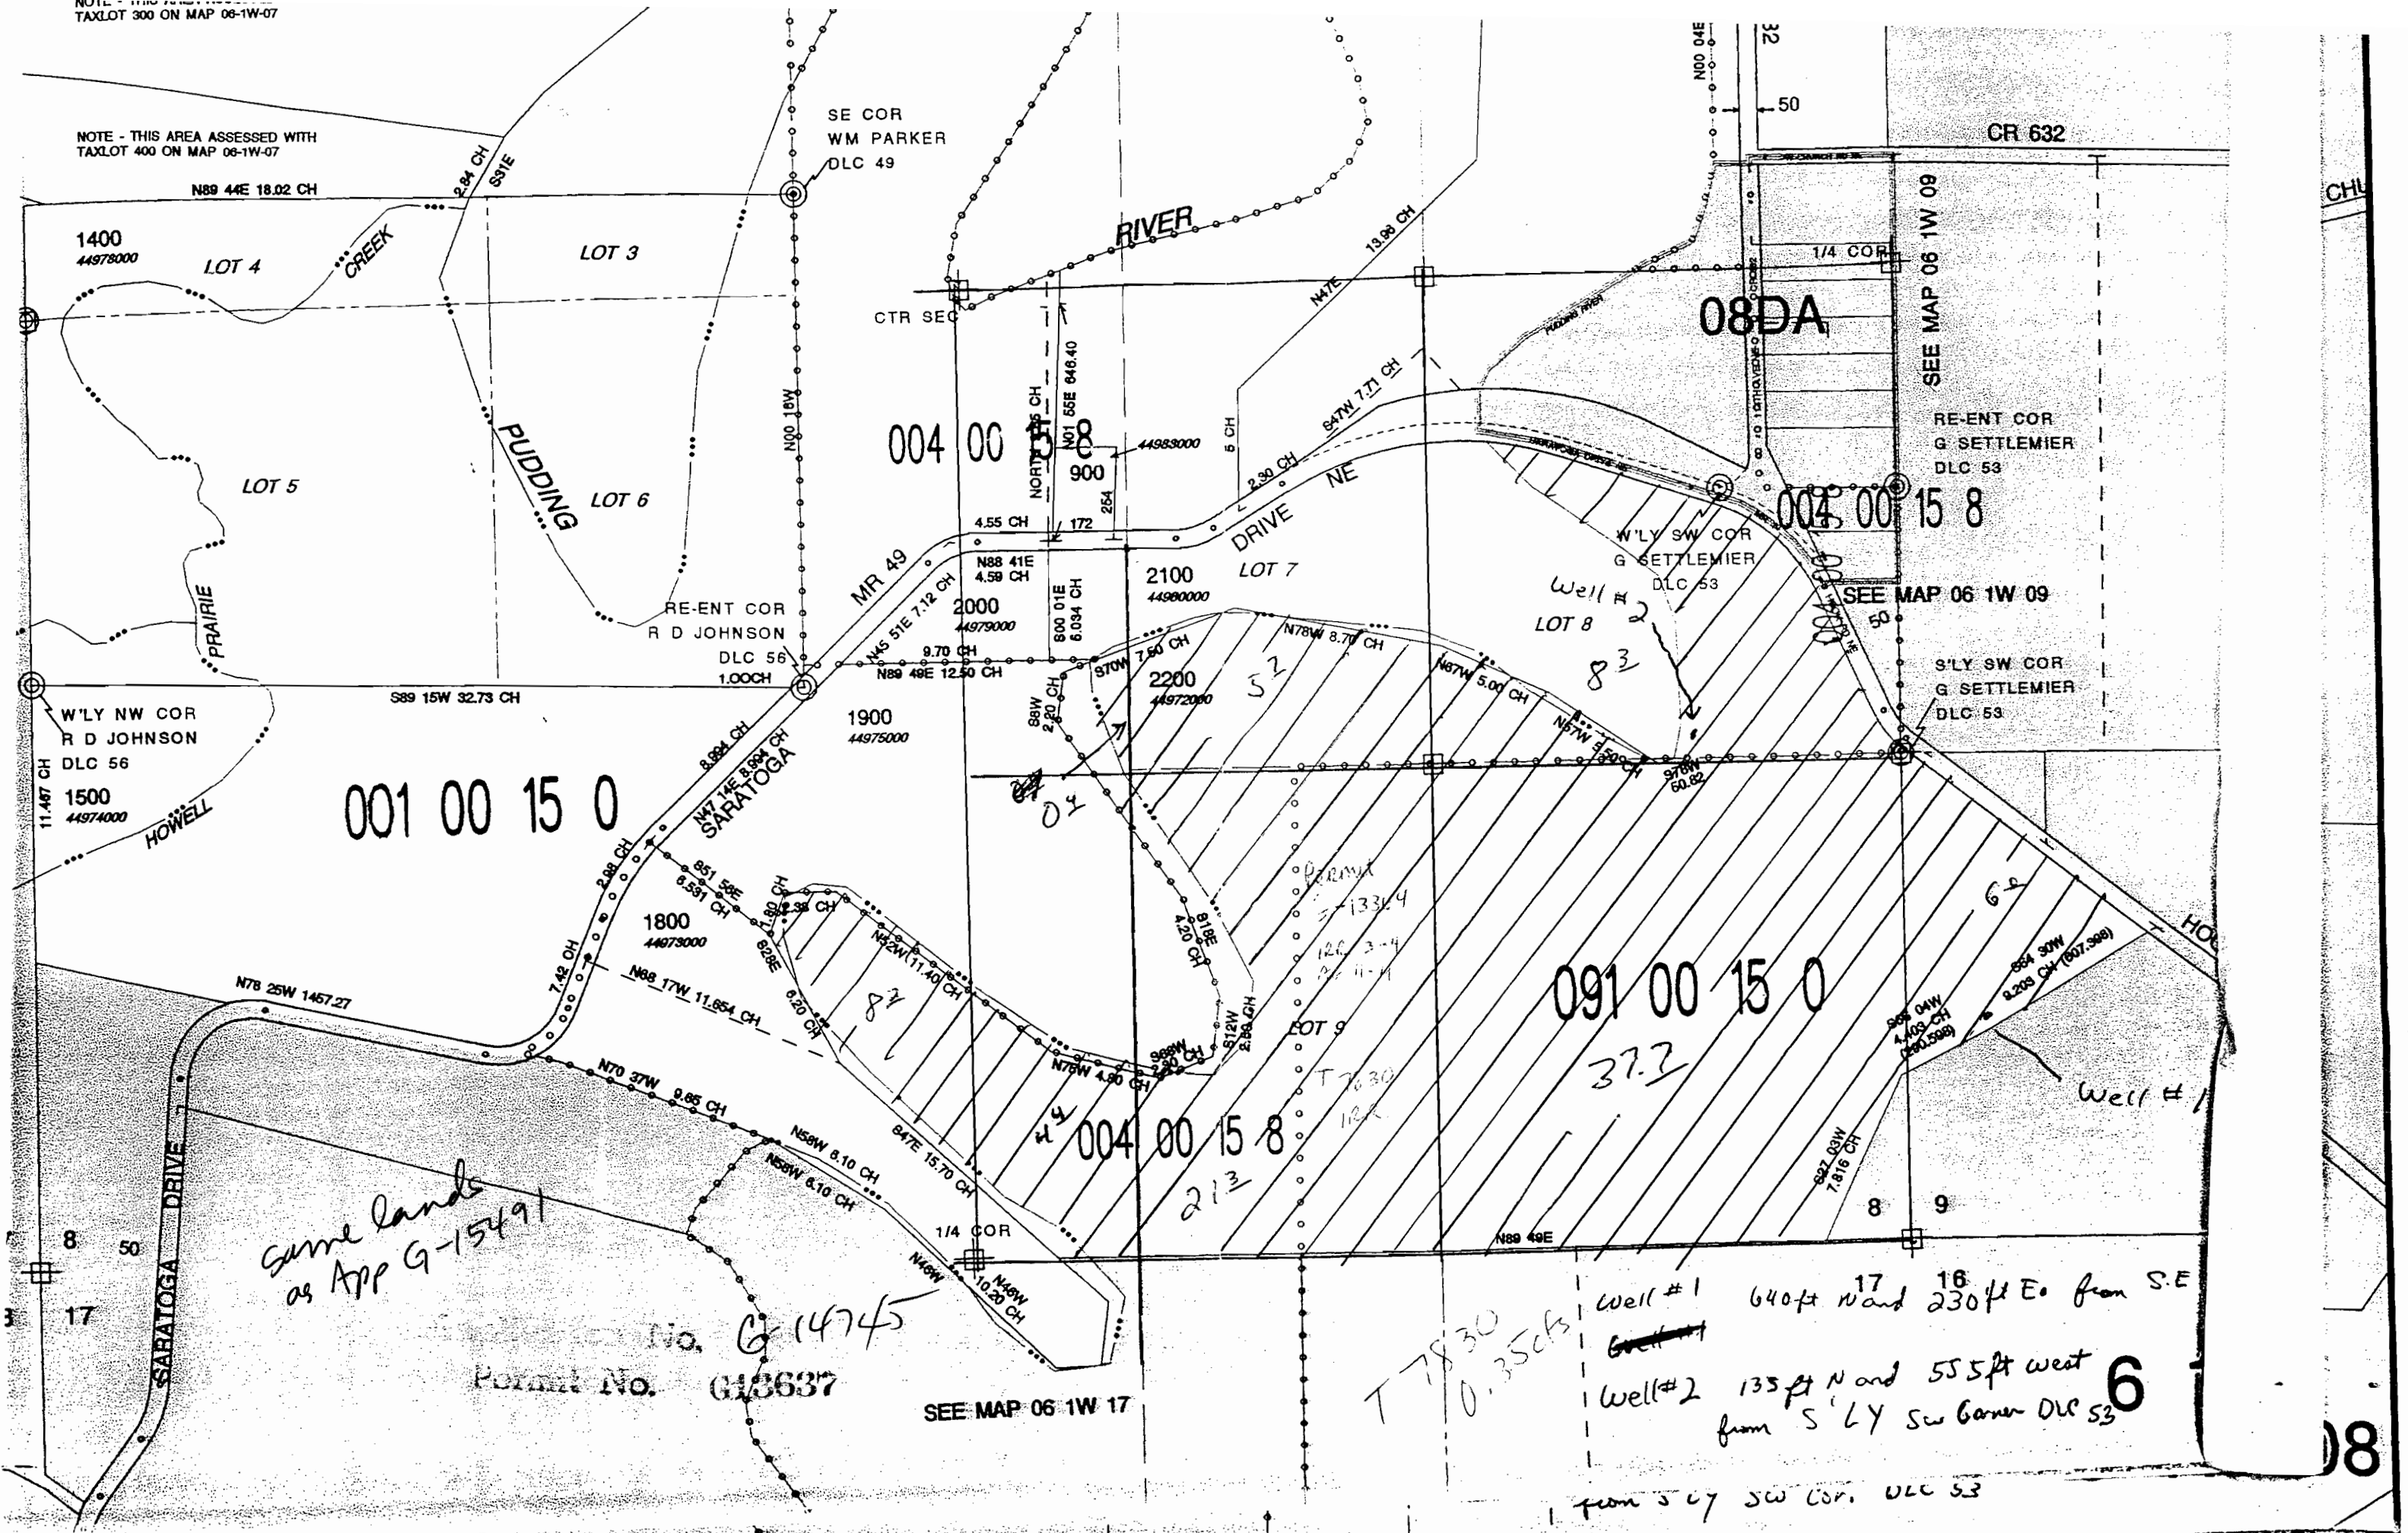

1400
44973000
LOT 4

LOT 3

LOT 5

LOT 6

004 00

2100
44980000
LOT 7

LOT 8

W'LY NW COR
R D JOHNSON
DLC 56

RE-ENT COR
R D JOHNSON
DLC 56
1.00CH

W'LY SW COR
G SETTLEMIER
DLC 53

RE-ENT COR
G SETTLEMIER
DLC 53

S'LY SW COR
G SETTLEMIER
DLC 53

001 00 15 0

1800
44973000

1900
44975000

2000
44979000

2200
44972000

091 00 15 0

004 00 15 8

LOT 9

*same lands
as App G-15491*

No. G (1474)
Permit No. G18637

SEE MAP 06 1W 17

Well # 1 640ft N and 230ft E. from S.E
Well # 2 135ft N and 555ft west
from S'LY SW Corner DLC 53

*T 78 30
0.35ch*

from S'LY SW COR. DLC 53