


Work Copy n

T.6N. R.35E.

UMATILLA COUNTY

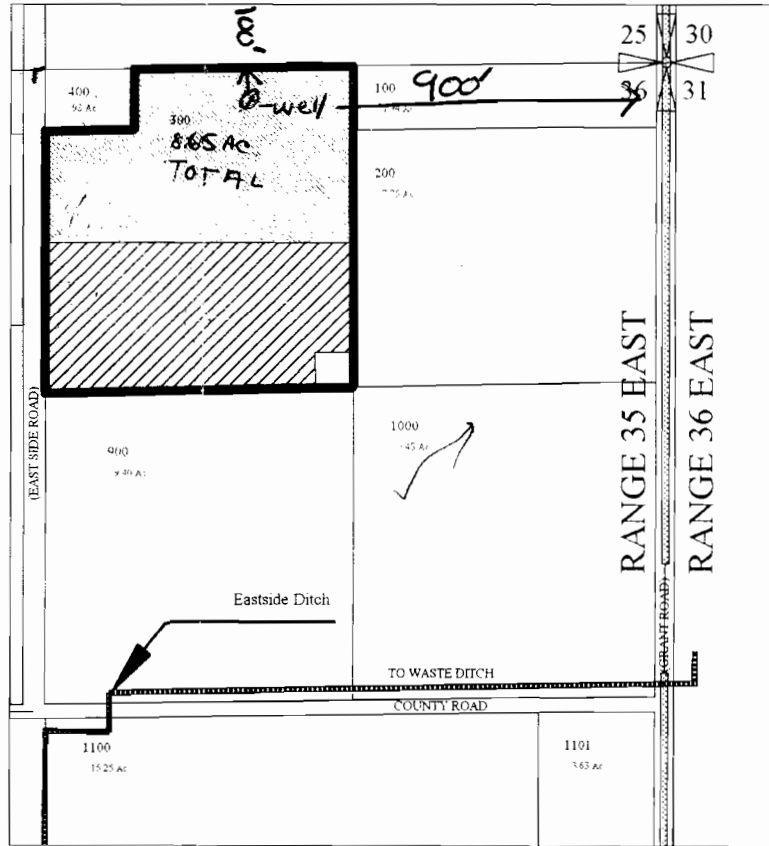

1" = 400'

GOOD SCALE APPROX.

NORTH

well Location -



Proposed new well right
8.65 acres

+



Existing Surface Right
Certificate 12802
Priority date 1894
4.5 acres

NOTE: APPLYING FOR GROUND WATER RIGHTS FOR BOTH EXAMPLES FOR TOTAL OF 8.65 ACRES

L.H.

Application No. 915598
Permit No. 15065

RECEIVED

AUG 27 2001

WATER RESOURCES DEPT
SALEM, OREGON

RECEIVED

NOV 24 2000

WATER RESOURCES DEPT.
SALEM, OREGON