


# T 41 S, R 11 E, WM Sec 2 East 1/2

MATCH TO

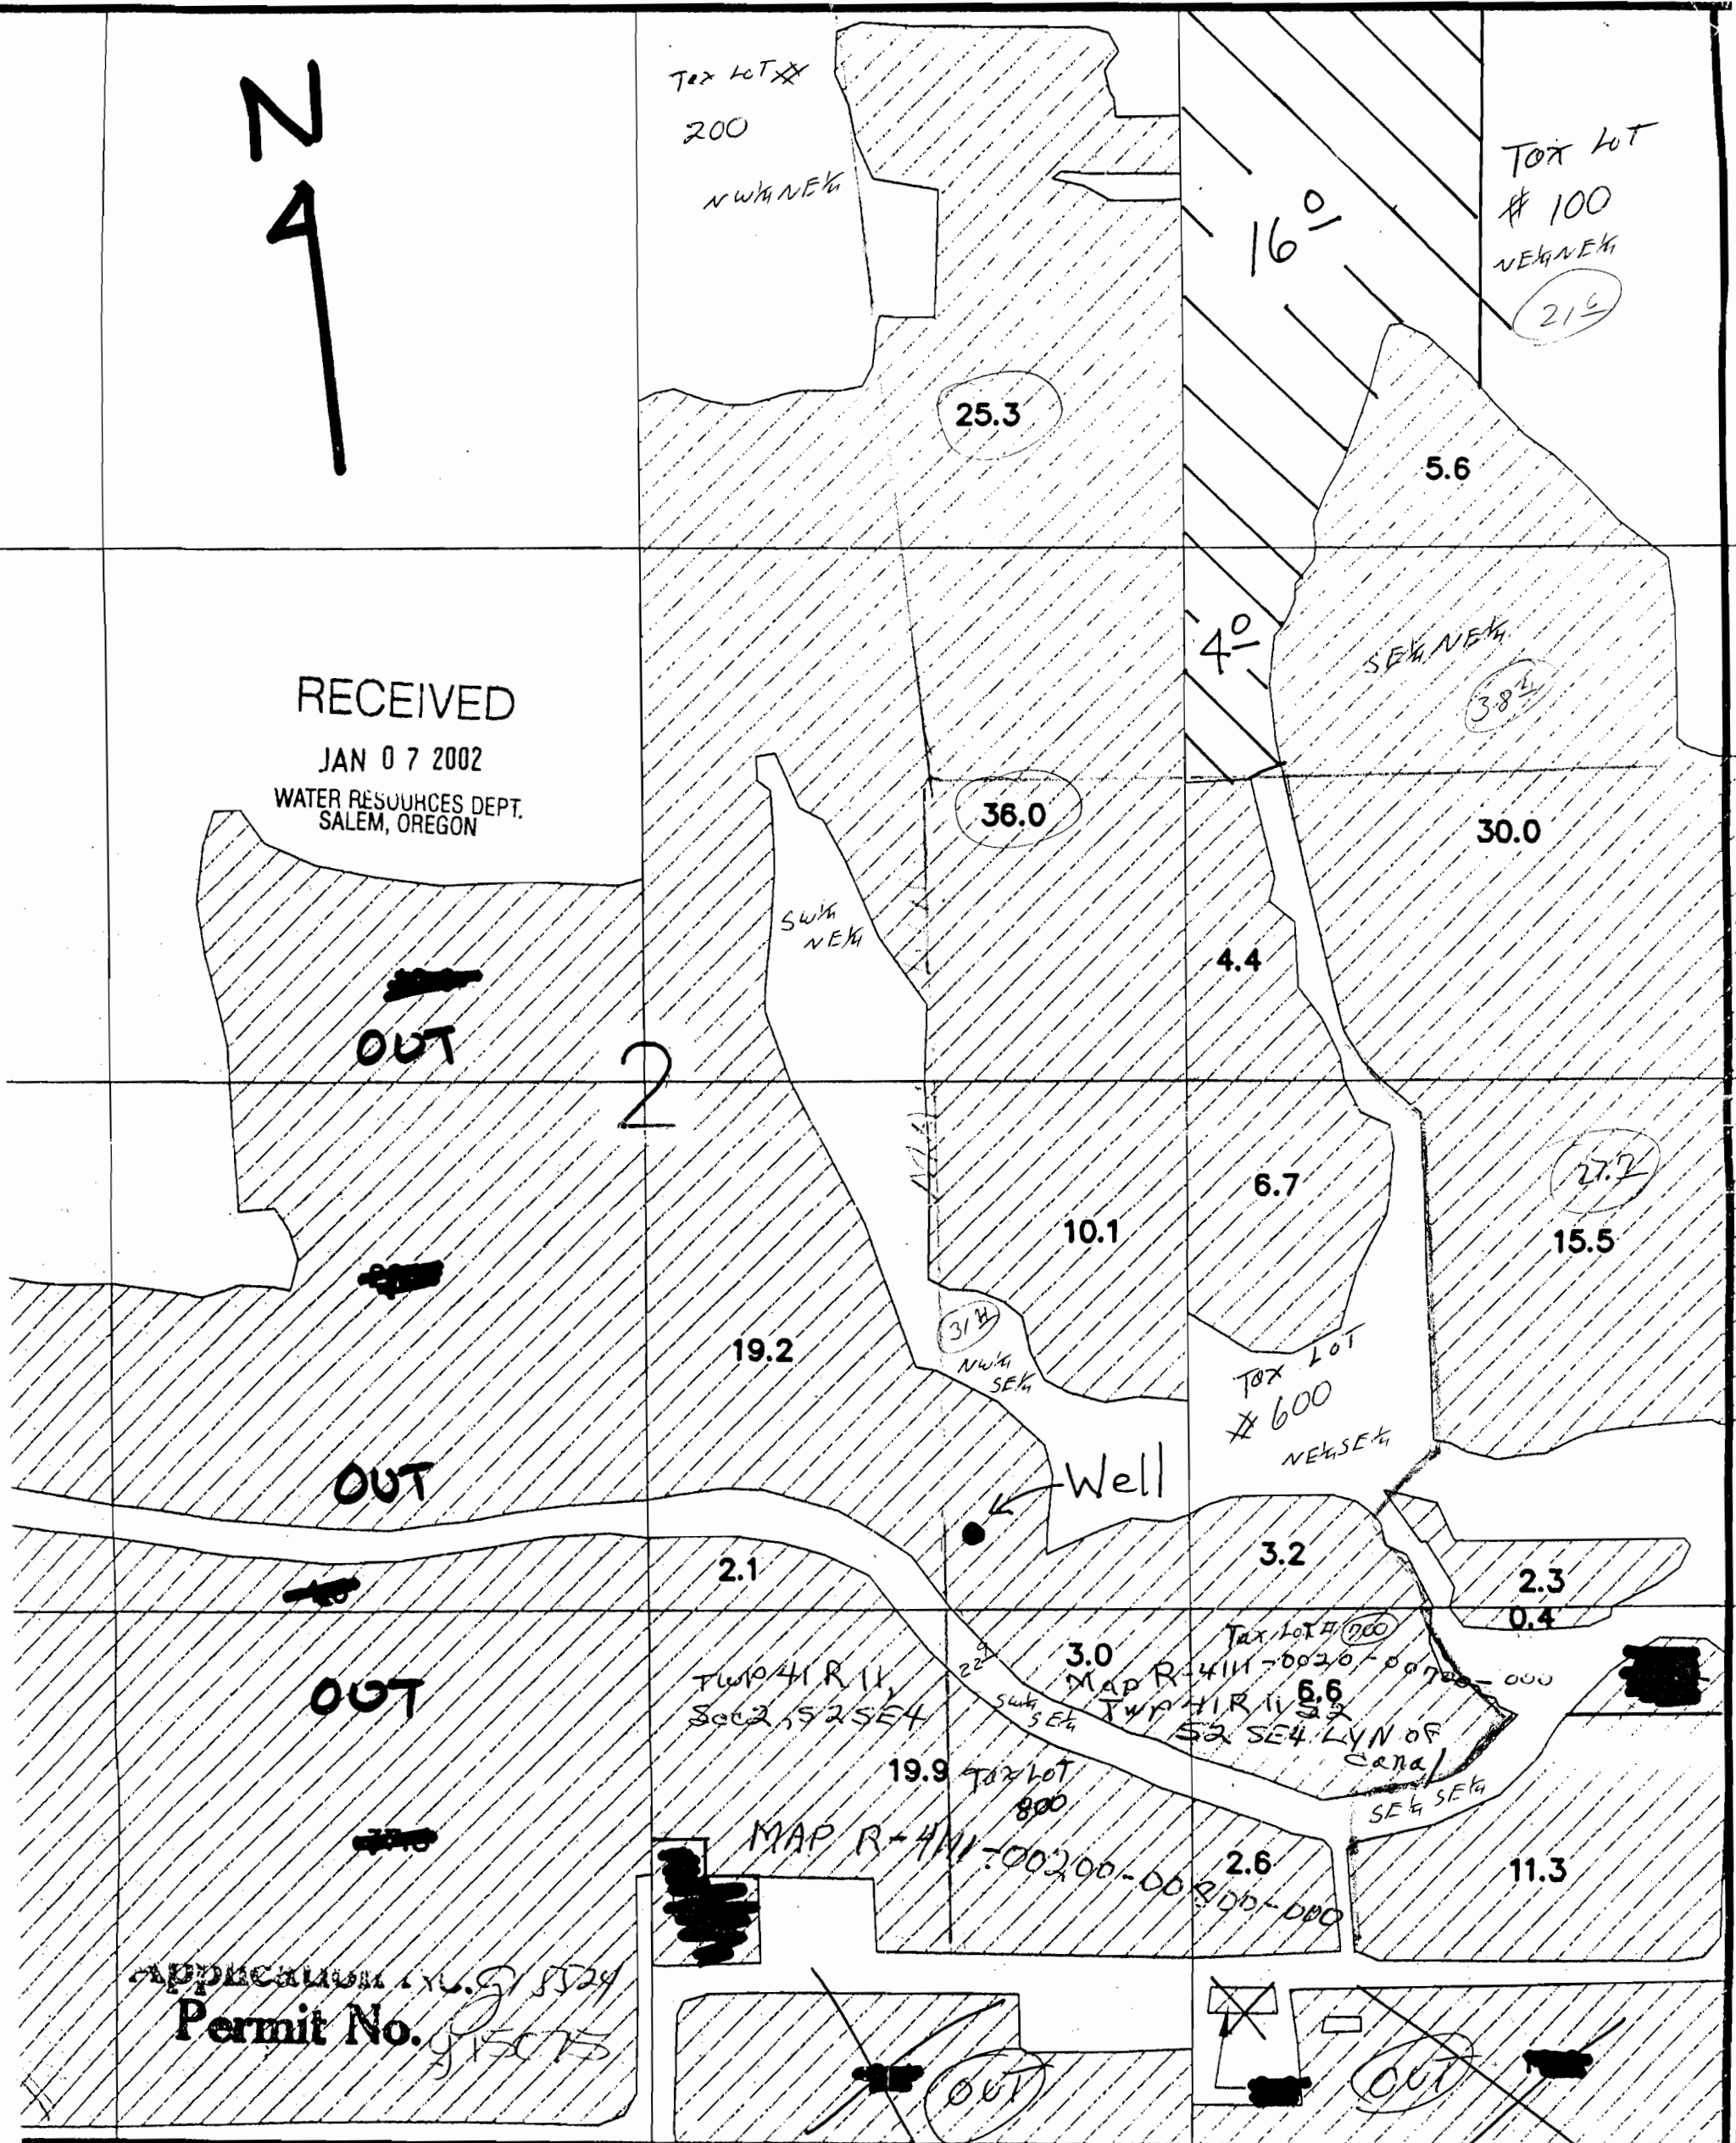

WELL LOCATION: 1500 feet NORTH AND 1800 feet WEST FROM the ~~SE~~ SE CORNER OF SECTION 2.

MATCH TO SH

ATION DOCUMENT 8-1

File # G-15524

SCALE 1" = 400'

APPLICATION MAP MO & MAE McKeon