


RECEIVED
MAY 17 2001

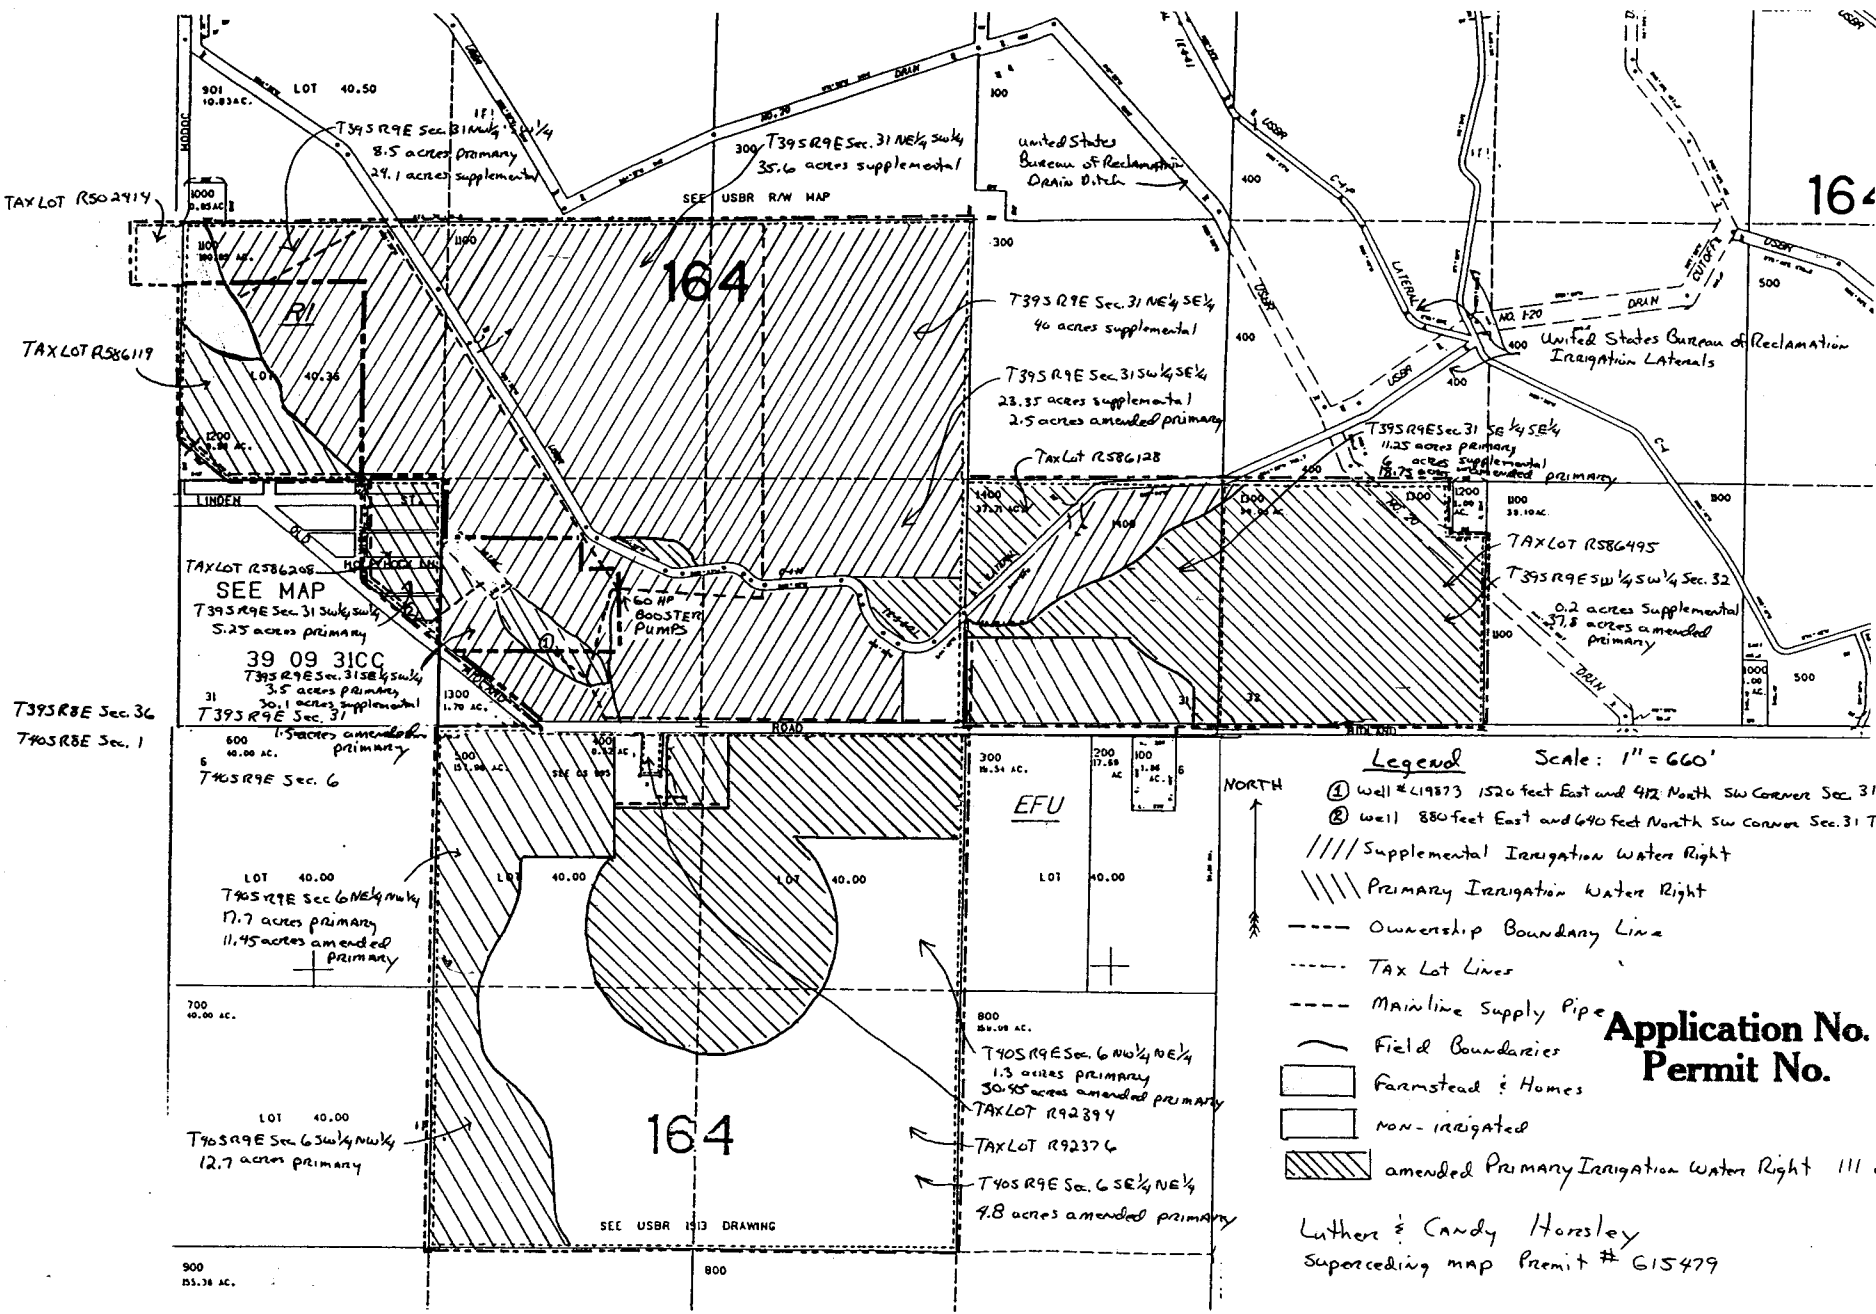

Legend Scale: 1" = 660'

① well # 419873 1520 feet East and 412 North SW Corner Sec. 31 T39S R9E
 ② well 880 feet East and 640 feet North SW Corner Sec. 31 T39S R9E

//// Supplemental Irrigation Water Right
 \\\ Primary Irrigation Water Right
 - - - Ownership Boundary Line
 - - - Tax Lot Lines
 - - - Mainline Supply Pipe
 ~ Field Boundaries
 □ Farmstead & Homes
 □ Non-irrigated
 ▨ amended Primary Irrigation Water Right 111 acres

Application No. G-15479
Permit No.

Luther & Candy Horesley
 Superseding map Permit # G15479