


MAP TO ACCOMPANY WATER RIGHT APPLICATION

SITUATED IN THE N 1/2 NE 1/4 NE 1/4 OF SECTION 07,
T39S, R08E W4, KLAMATH COUNTY, OREGON August, 2001

TAX LOT NO.
39 08 07 100



SCALE 1" = 400'

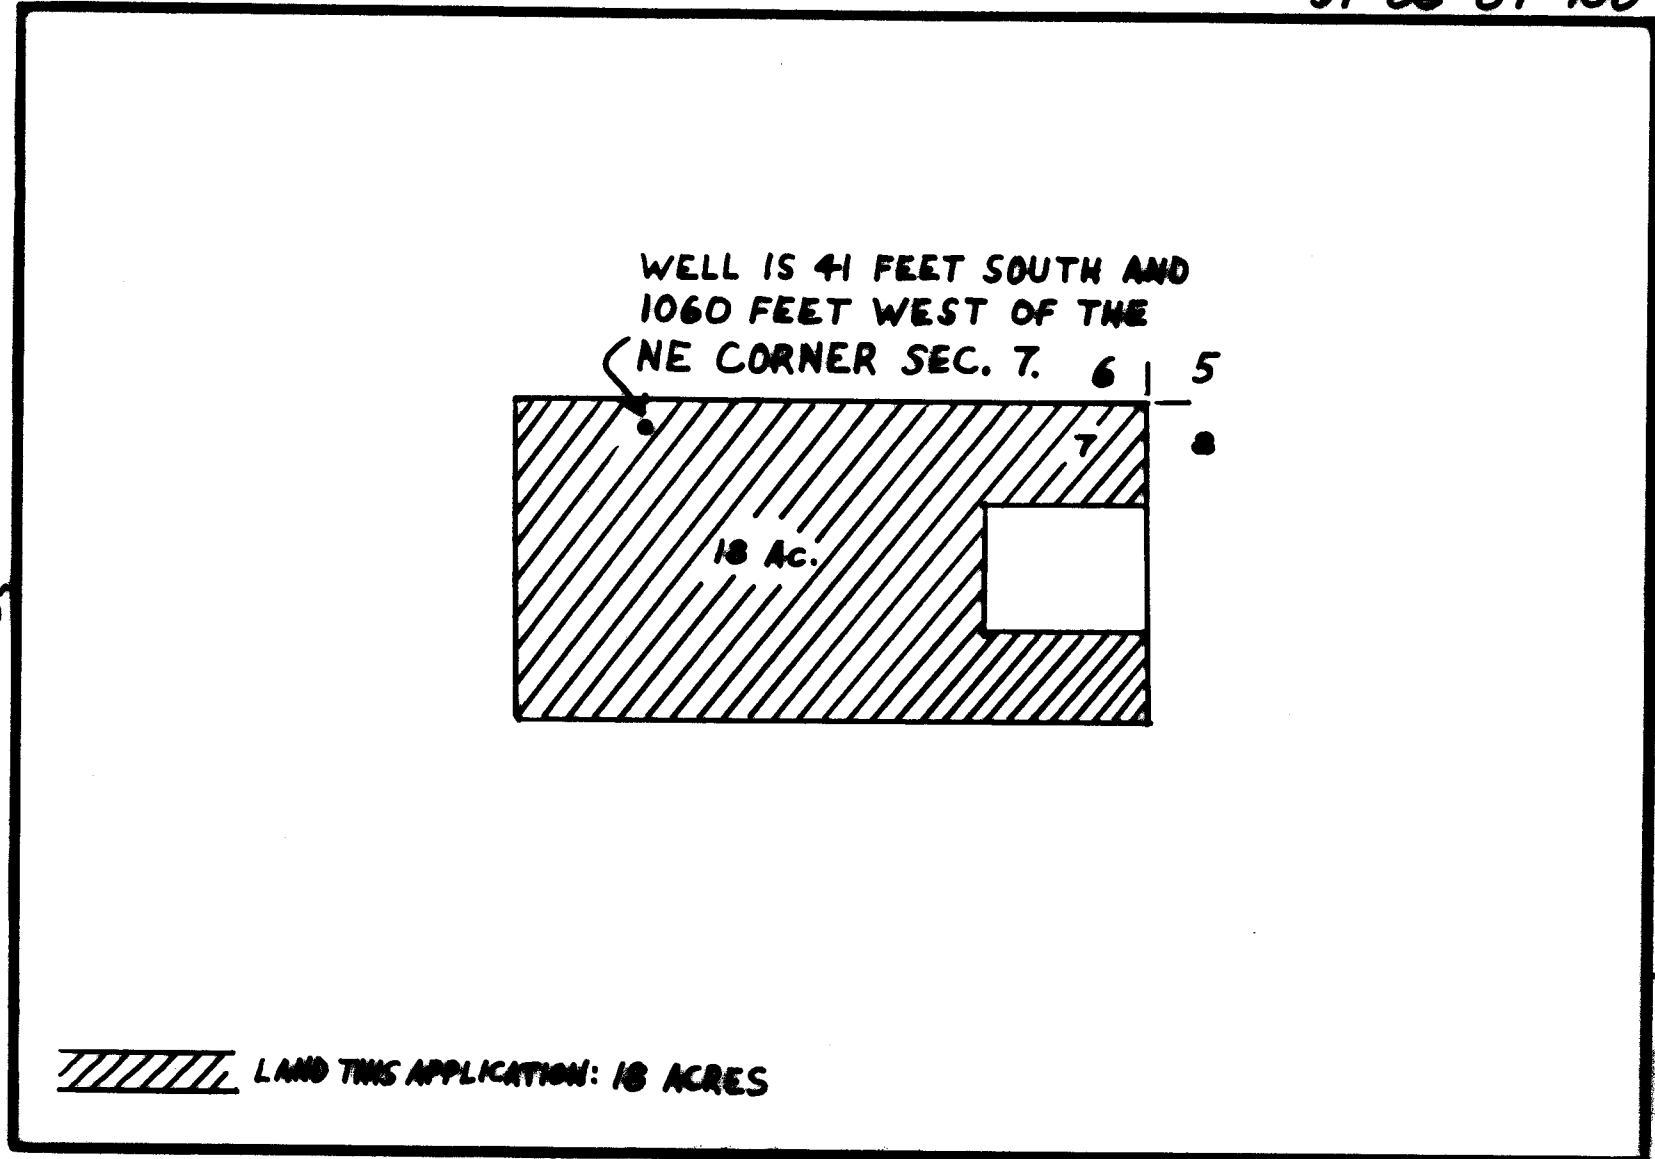

Applicants & Property Owners: Kevin P. & Tressie S. Rickel's
2530 Round Lake Rd.
Klamath Falls, OR 97601
Ph: 273-8395, 892-6613

RECEIVED
AUG 07 2001
WATER RESOURCES DEPT
SALEM, OREGON