


RECEIVED
OCT 25 2001
WATER RESOURCES DEPT
SALEM, OREGON

Michaels & Anderson Application MAP

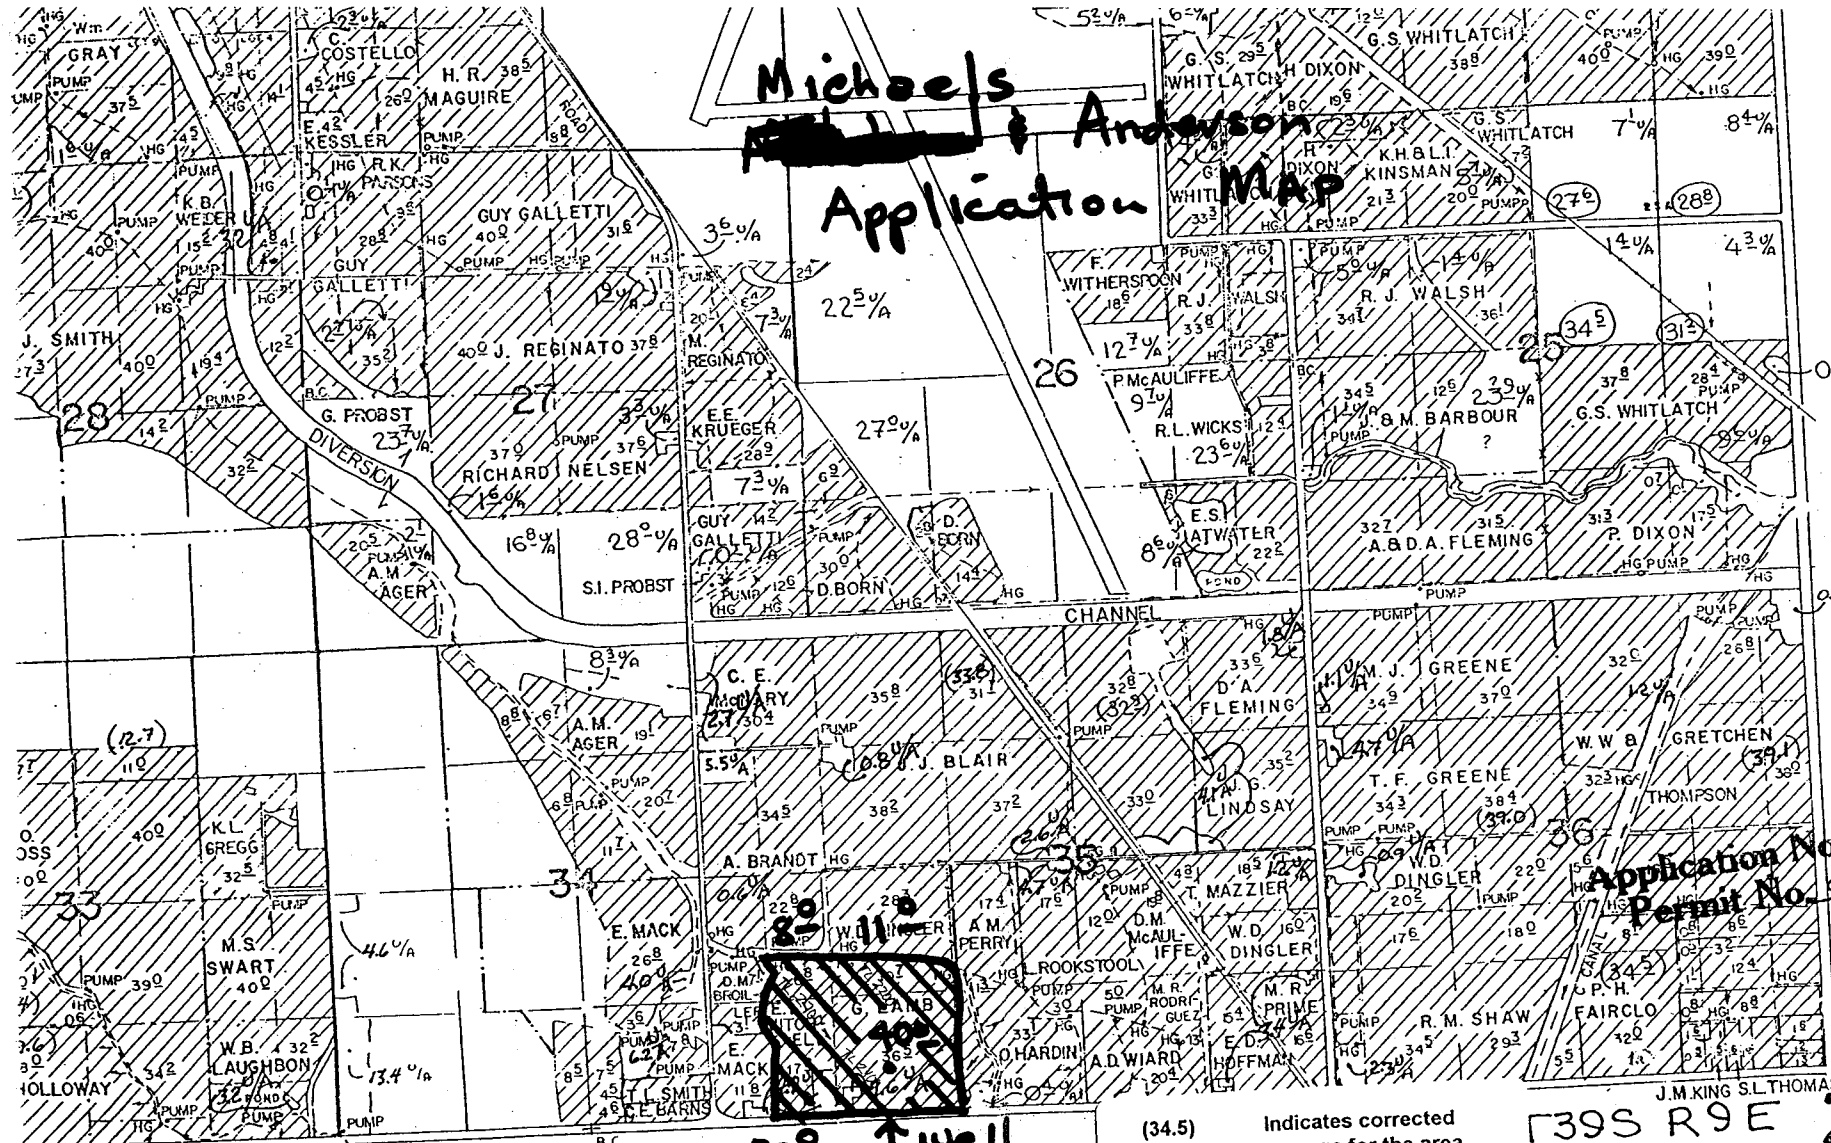

↑
1" = 132'

Application No. 97544
Permit No. 6-15124

20± well
500 feet North and
600 feet East from the SW Corner Section 35.

(34.5) Indicates corrected acreage for the area
34.0 u/a Indicates unirrigated acreage under contract

T39S R9E 79
39S 9E

97 301 0157