Section 02 T. 40S. R. 09E. W M

KLAMATH COUNTY Tax Lot 1200

Existing 8" PVC mainline Underground

1"=400'

Proposed Well

From Southeast Corner of Sec 02 Go West 2652.10

From This point Go North 1360' North to Well

RECEIVED

MAY 0 3 2001

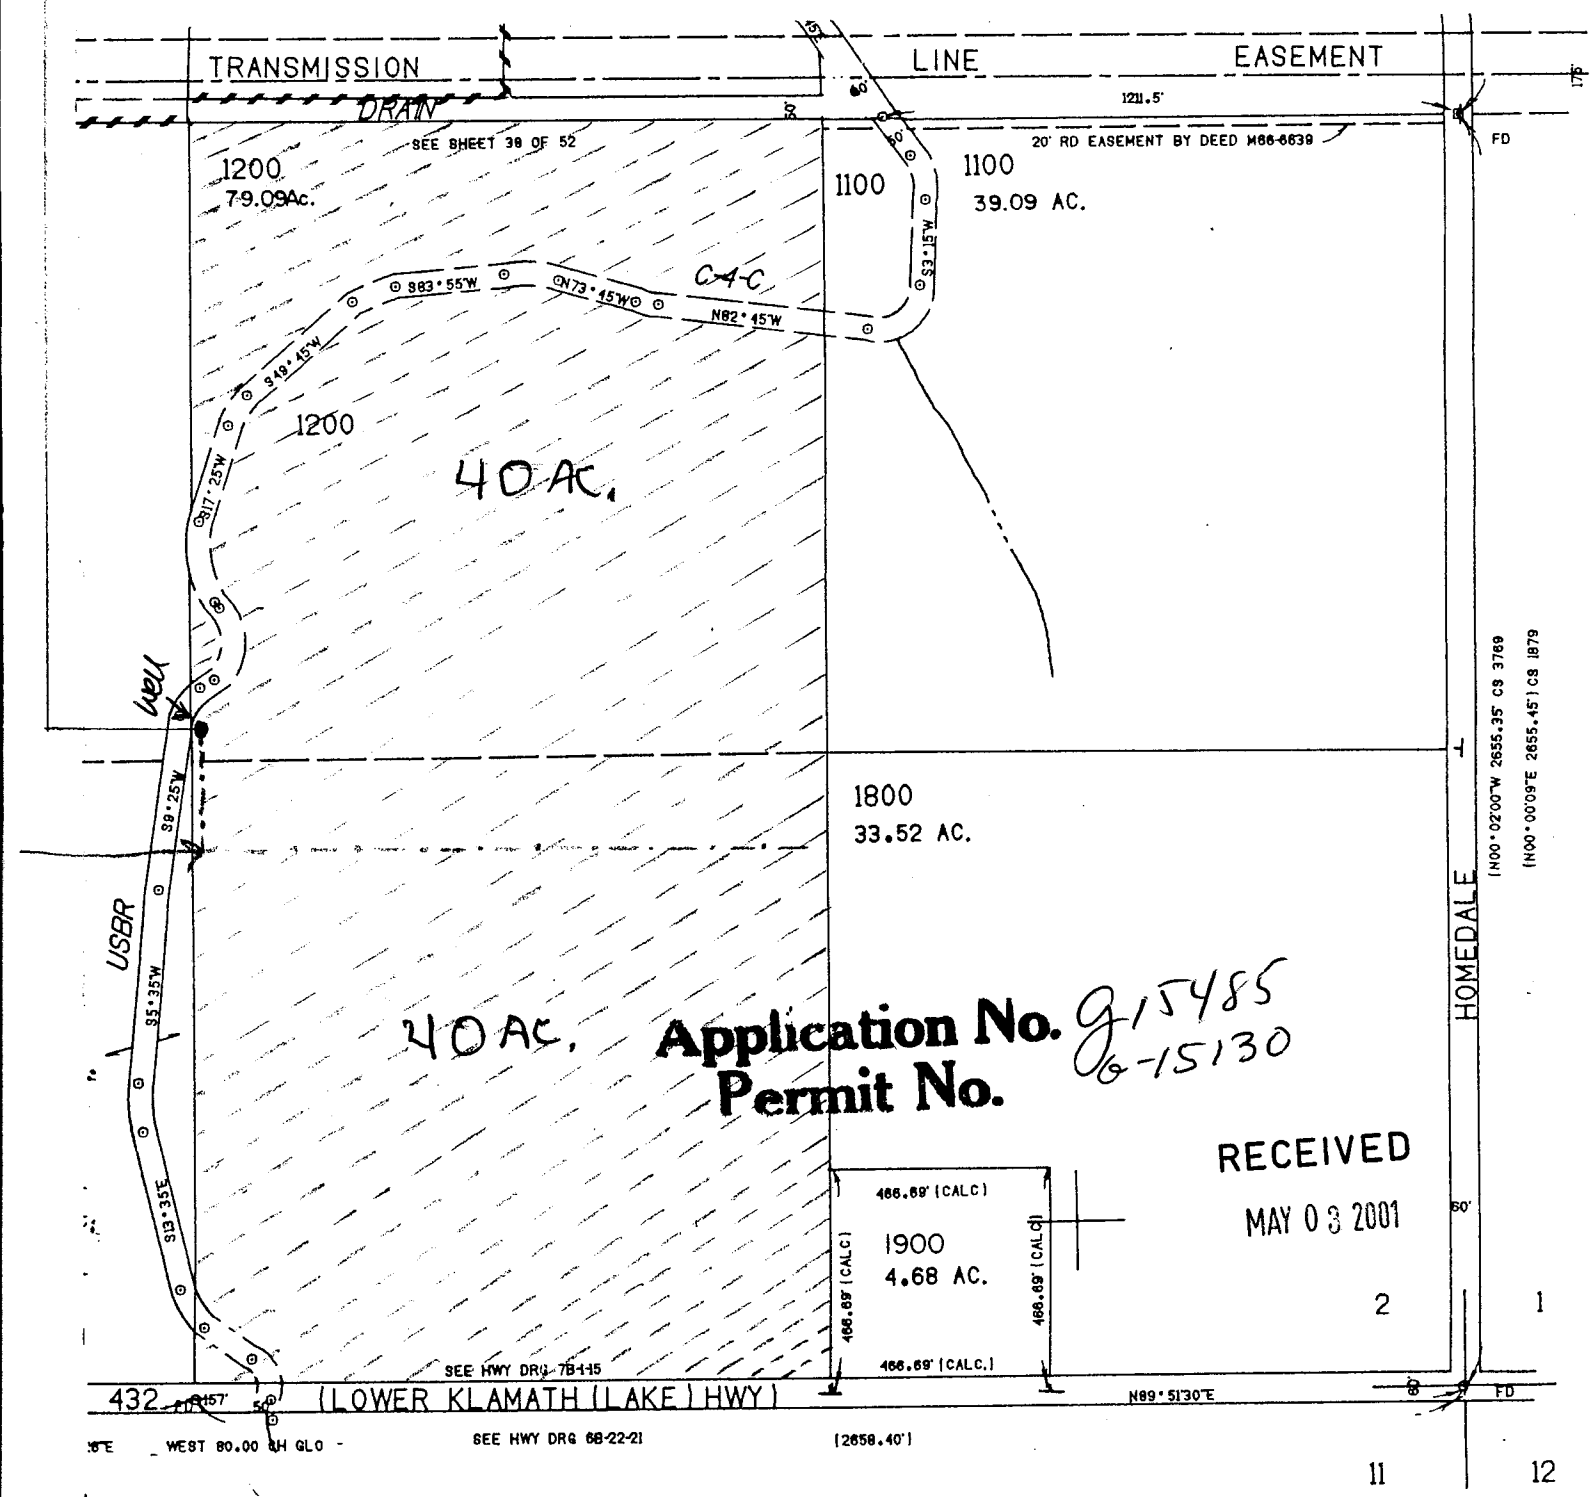

E MAP 40 09 11