
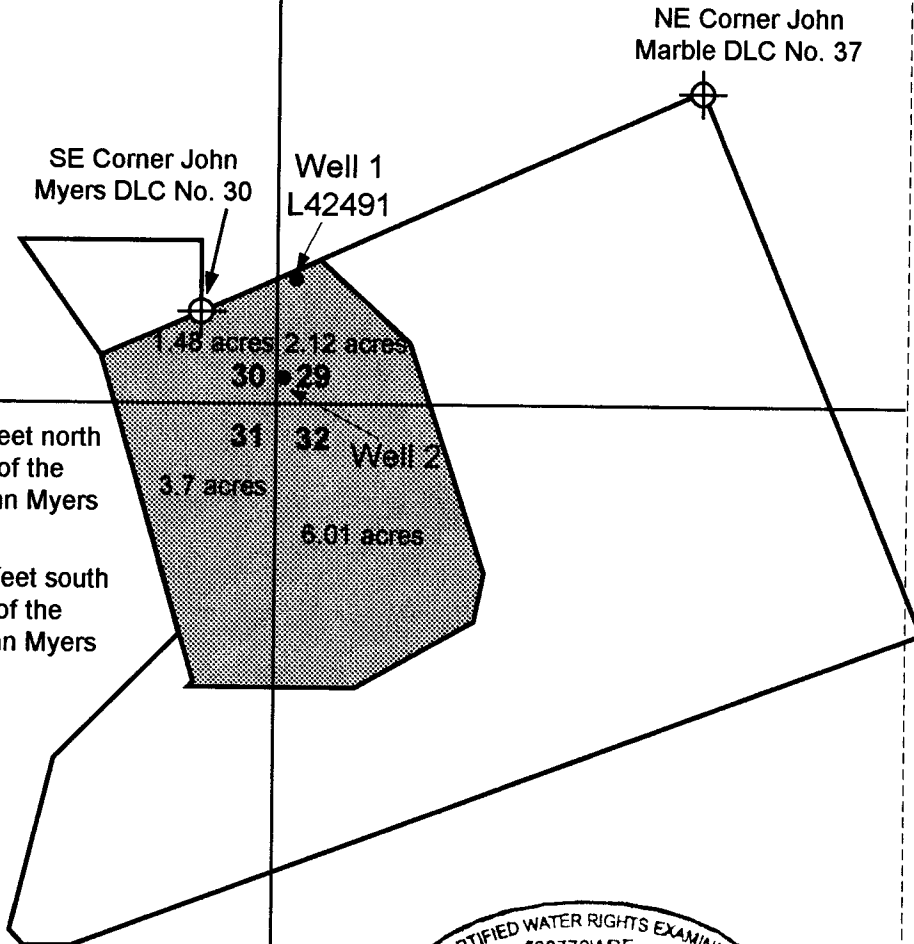



T.2S. R.3W. Sec. 32 TL 1490

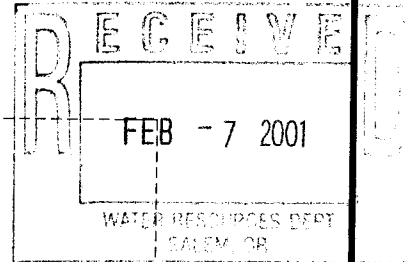

Well 1 is located 90 feet north and 220 feet east of the southeast corner, John Myers DLC.

Well 2 is located 130 feet south and 170 feet east of the southeast corner, John Myers DLC.


Application No. 915306
Permit No. 91531

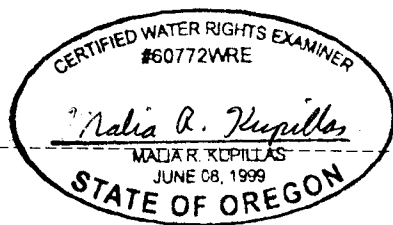

EXPIRATION DATE: 12/31/01

Area to be irrigated, 13.31 acres.

Scale: 1" = 400'

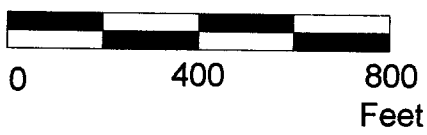

This map was prepared for the purpose of identifying the location of a water right only and is not intended to provide legal dimensions or location of property ownership lines.



Permit Application Map for Groundwater Rights

Pacific Hydro-Geology Inc.

Ribbon Ridge Vineyards
T.2S. R.3W Sec. 32, TL 1490