


AMENDED
MAP

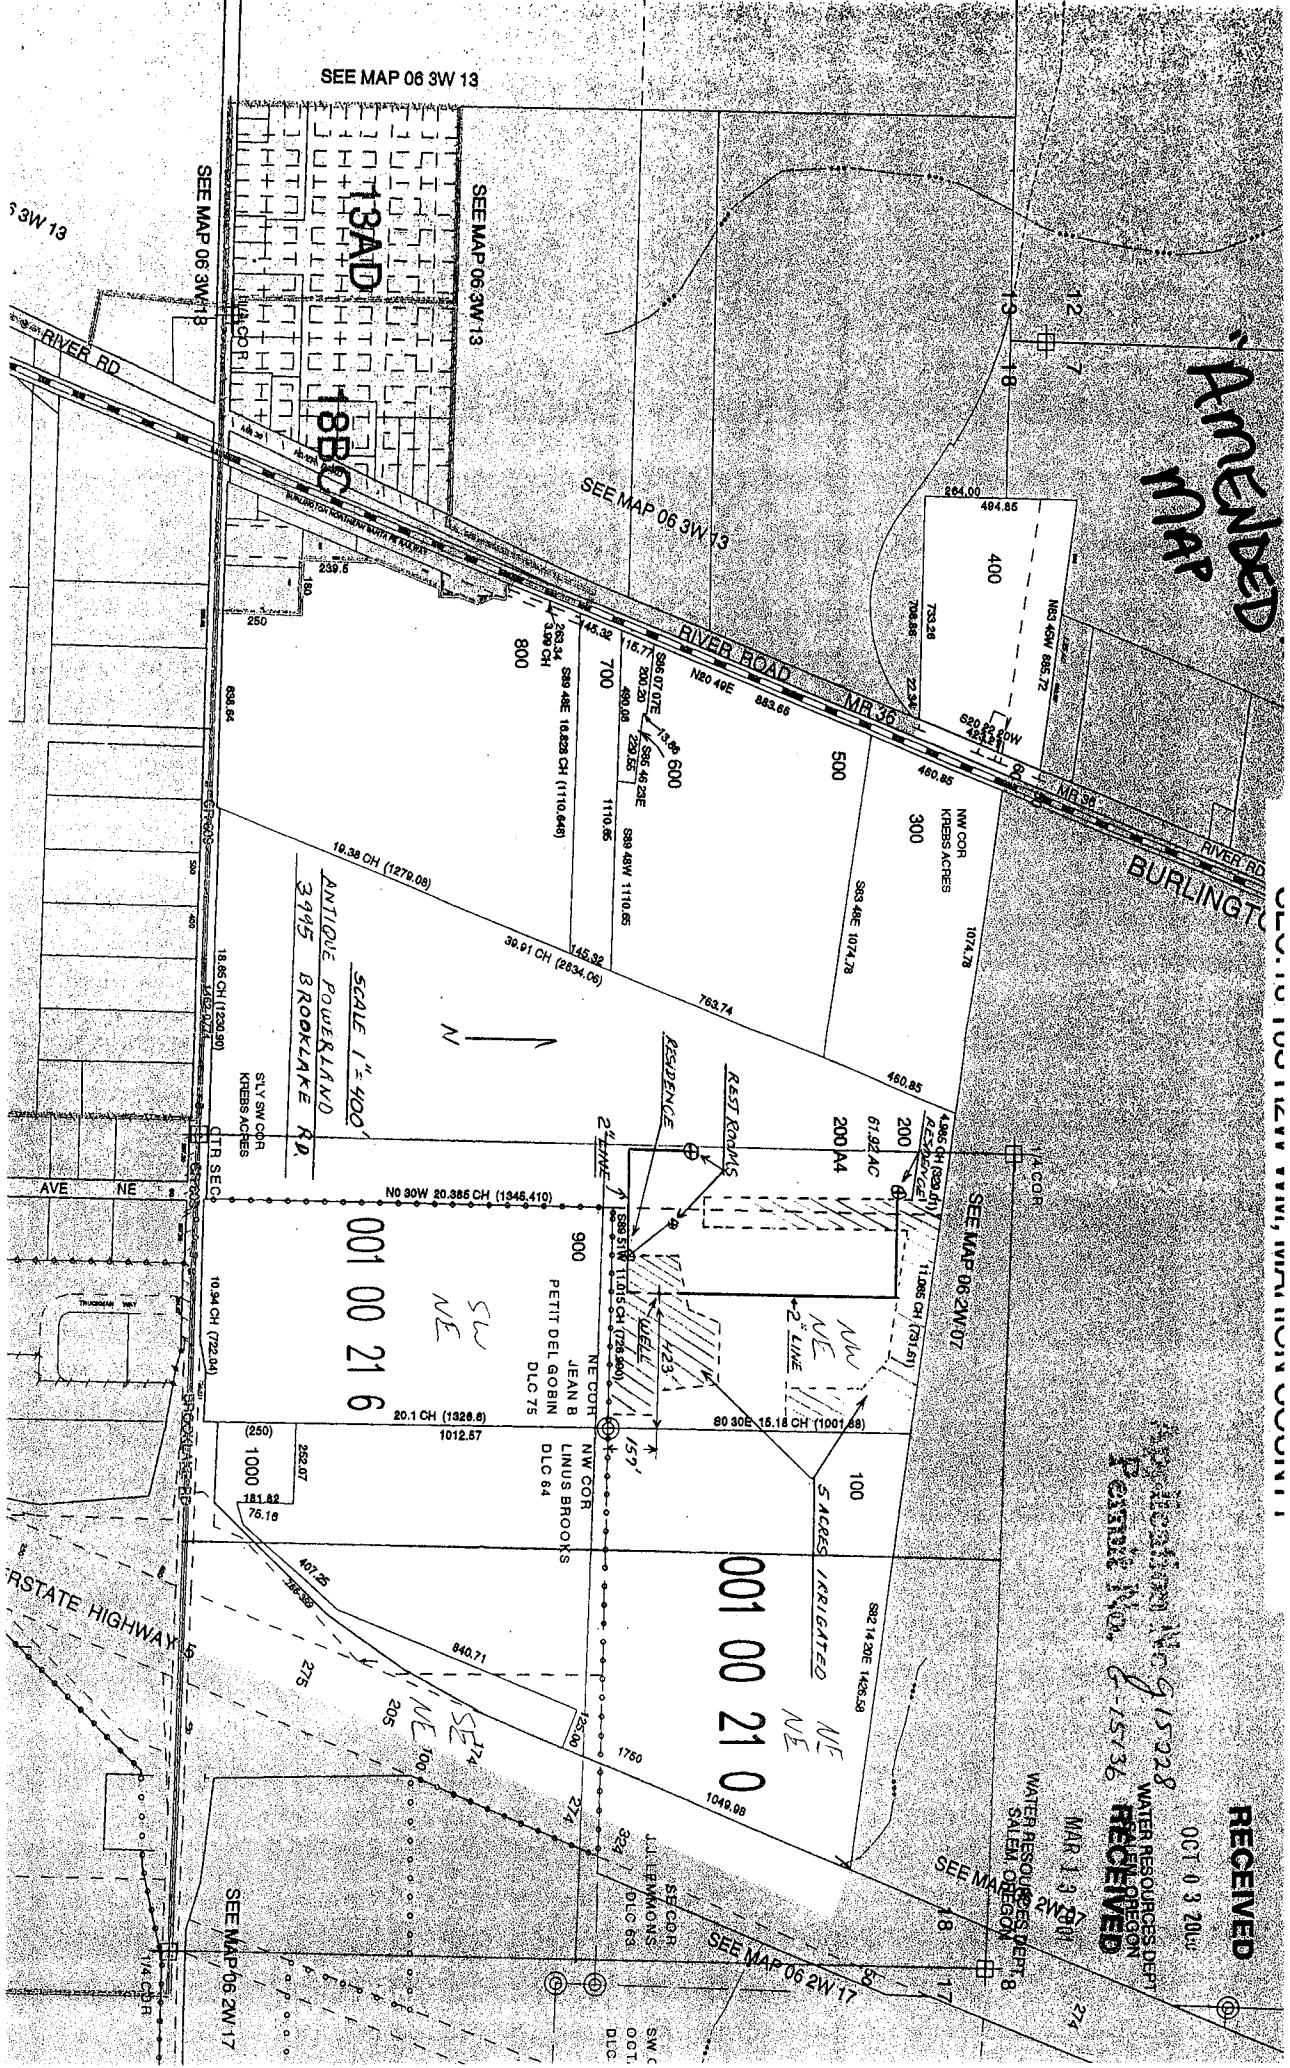

RECEIVED
MARCH 13 2006
WATER RESOURCES DEPT


