



USE THESE ACRES

T 41 S R 11 E
SECTION 4

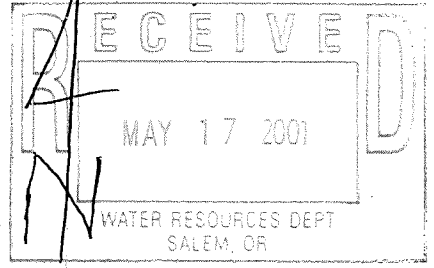

1" = 400'

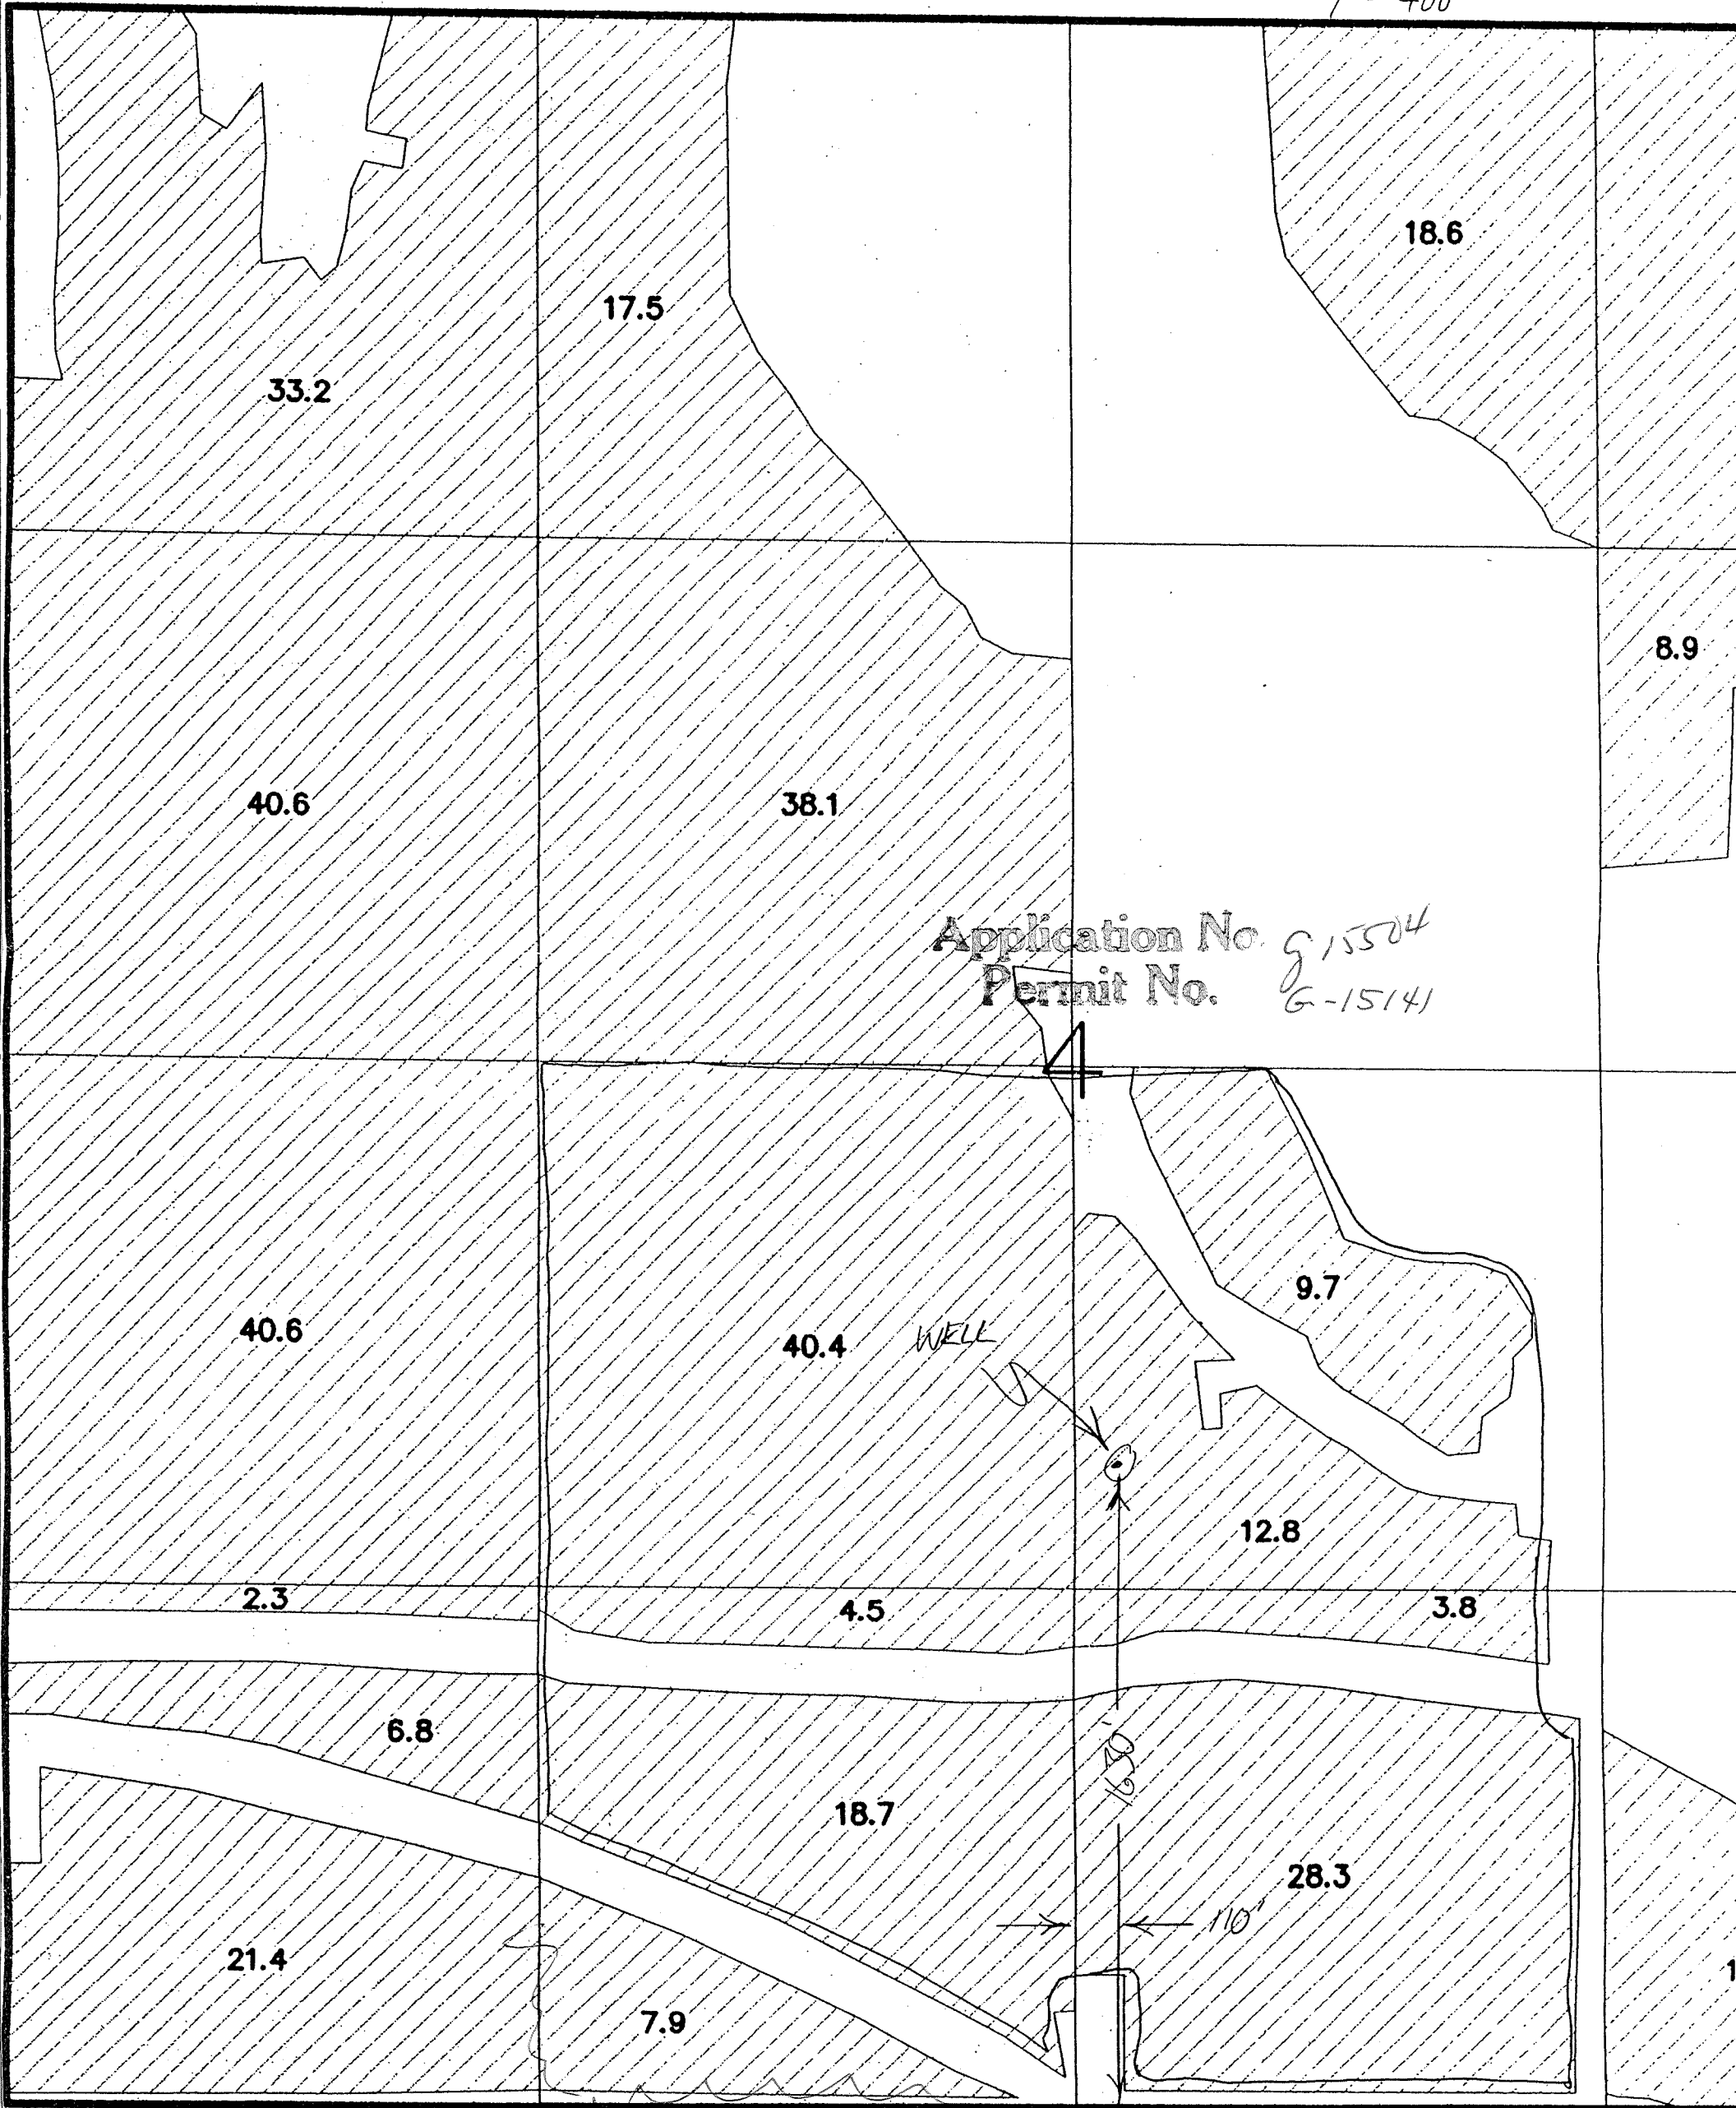

Application No. G-15504
Permit No. G-15141

33.2

17.5

18.6

40.6

38.1

8.9

40.6

40.4

WELL

9.7

2.3

4.5

12.8

3.8

6.8

18.7

28.3

21.4

7.9

110'

100'