
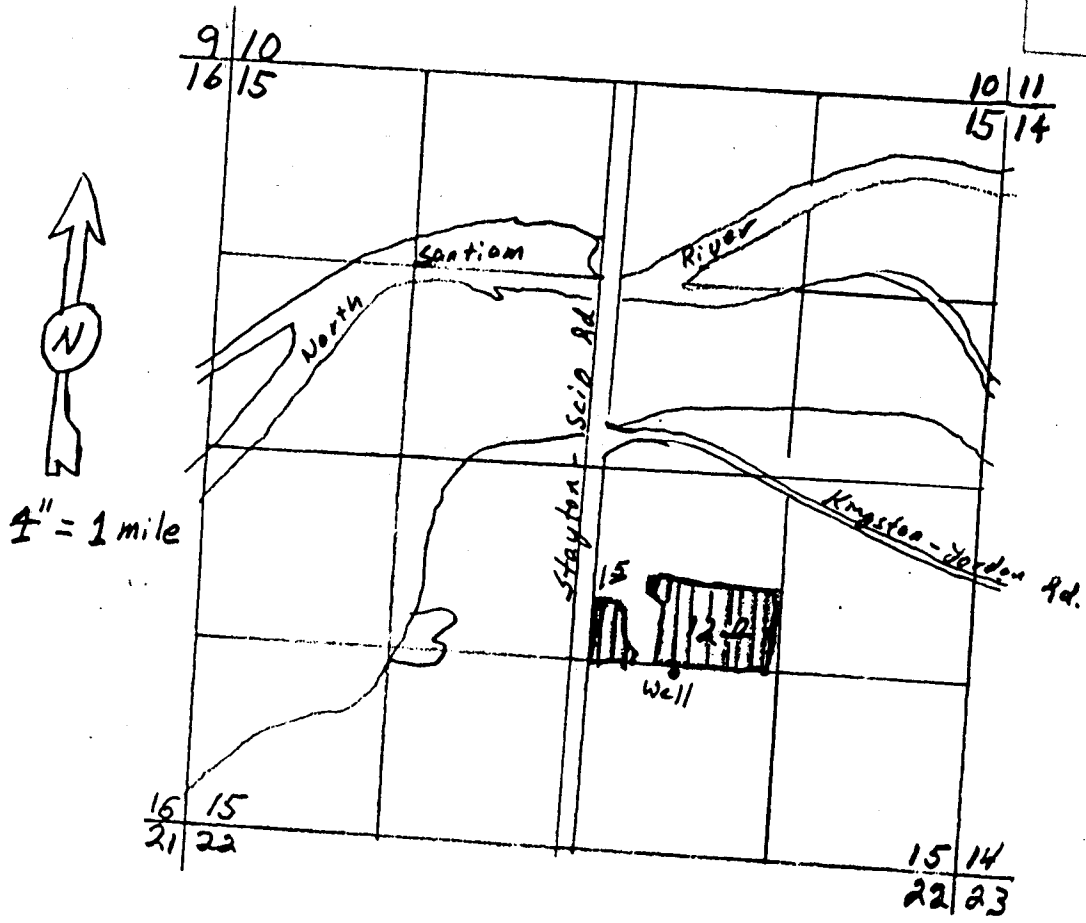


T. 9S. R. 1W W.M.

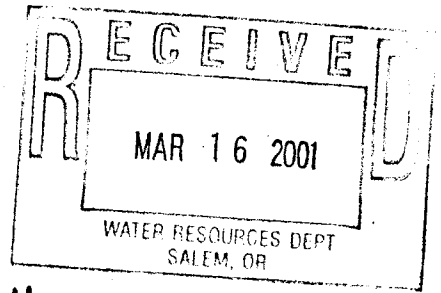

MAP 1 of 2

Point of Diversion (Well): 1300 N and 500' E of S¹/₄ Cor Sec 15

Ground Water Right Application Map
For: CN-CR, LLC
March 29, 2000

Application No. 915345
Permit No. 6015154