


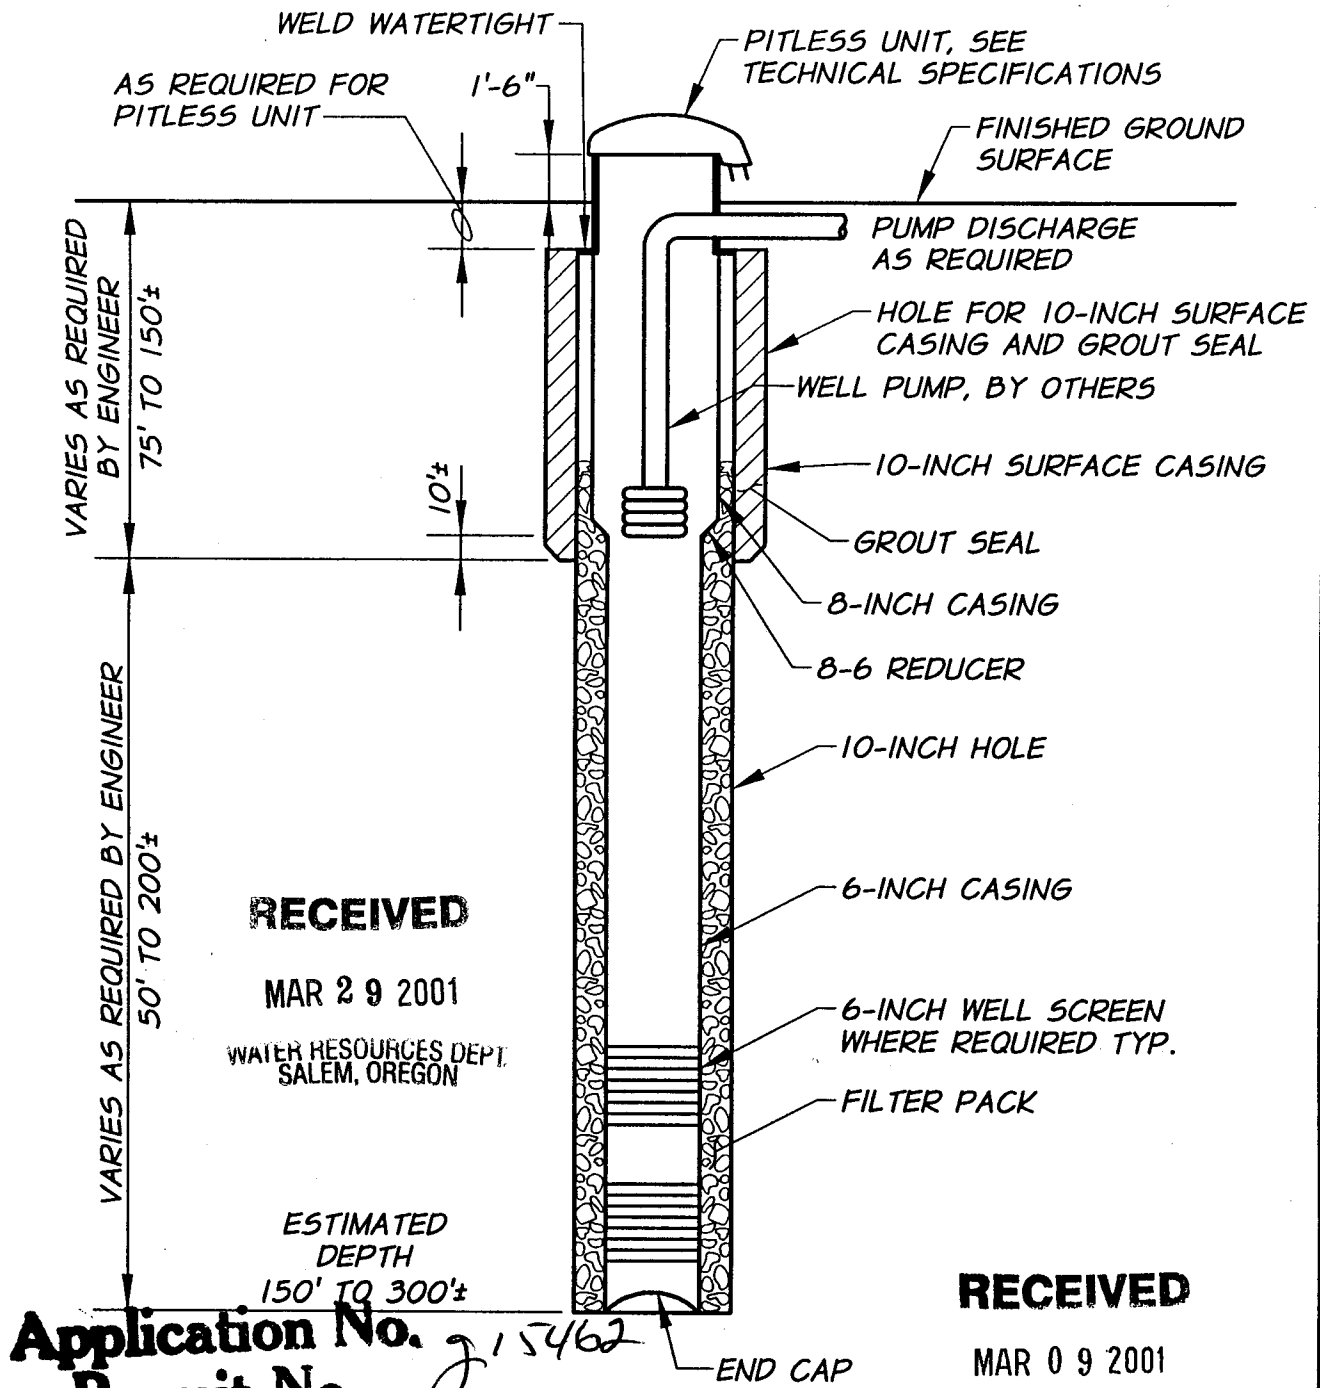

RECEIVED

MAR 29 2001

WATER RESOURCES DEPT.
SALEM, OREGON

RECEIVED

MAR 09 2001

WATER RESOURCES DEPT.
SALEM, OREGON

Application No. 215462
Permit No.

NOTE:

LOCATIONS OF VARIOUS WELL DEPTHS
SHOWN ARE ESTIMATES. DEPTH AND
LOCATION COULD VARY CONSIDERABLY.

LAST UPDATED: 2/15/01

**anderson
perry**
associates, inc.

CITY OF LA GRANDE
WASTEWATER SYSTEM IMPROVEMENTS
PHASE I - SCHEDULE A
ANTICIPATED WELL CONSTRUCTION

FIGURE

2

N
Scale 1"=1000'

LA GRANDE
323.00 AC.

7500
323.00 AC.

SEE GS 188


RECEIVED
MAR 29 2001
WATER RESOURCES DEPT.
SALEM, OREGON

FIGURE 3

RECEIVED
MAR 09 2001
WATER RESOURCES DEPT.
SALEM, OREGON

Application No. 915462
Permit No.

Corner of Sections
31, 32, 5 & 6

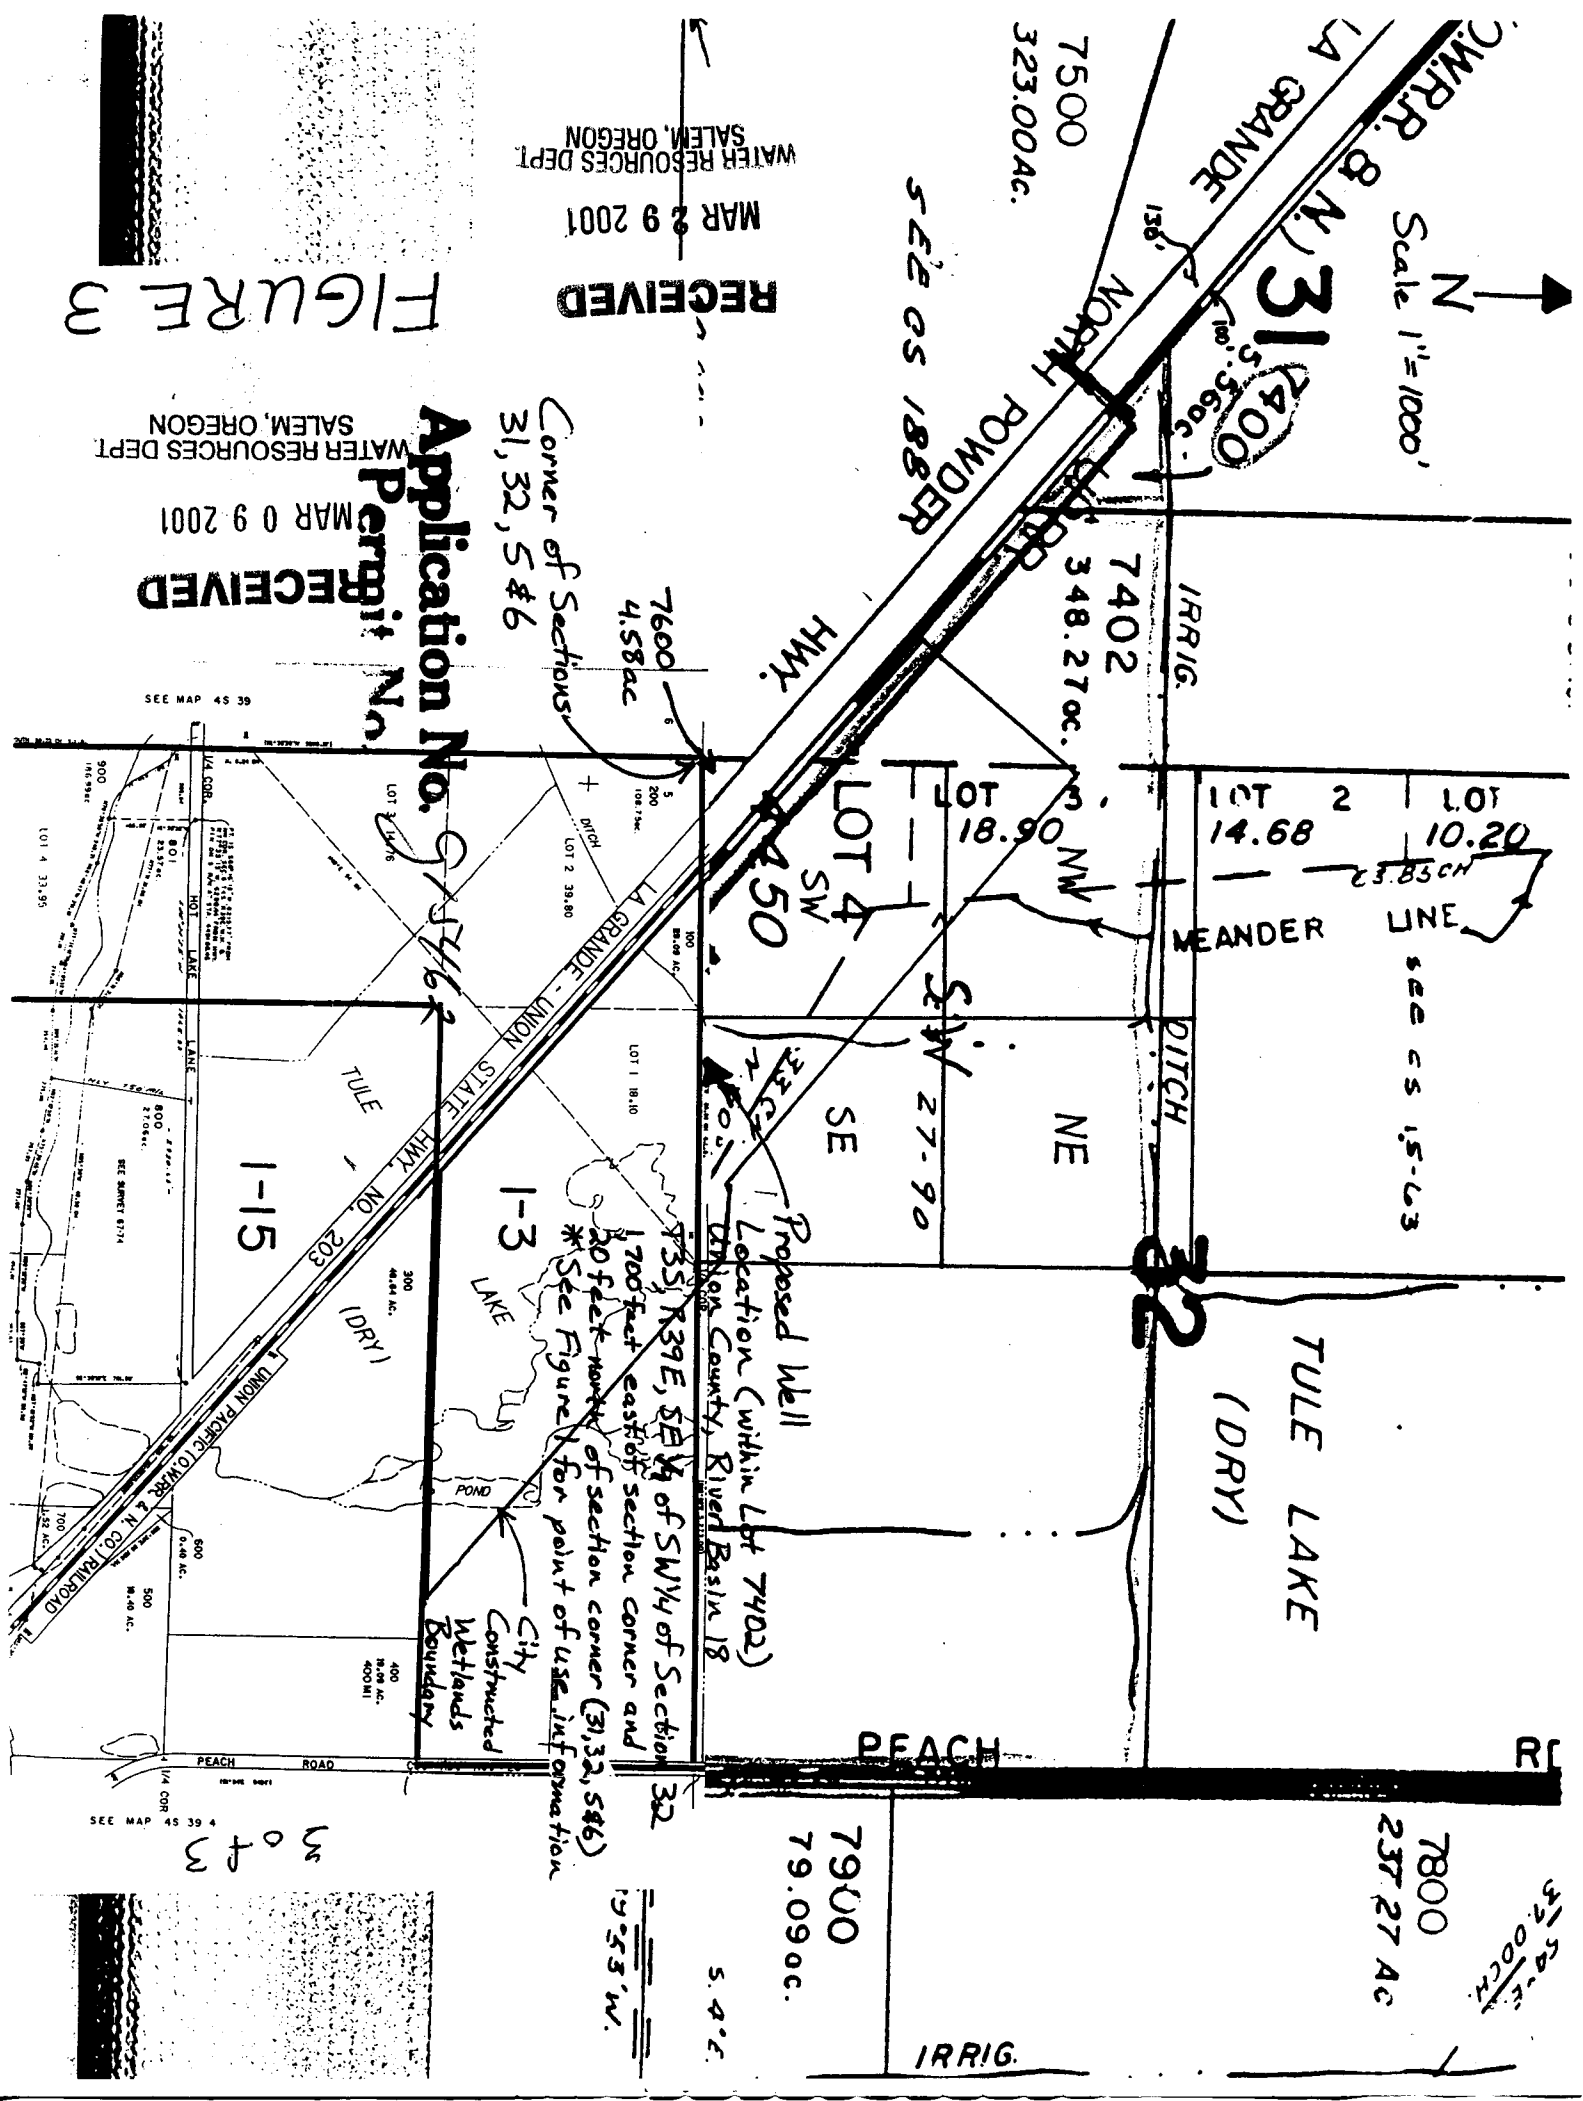

LOT 2 14.68
LOT 10.20
MEANDER LINE
SEE GS 15-63

PITCH 32

TULE LAKE
(DRY)

PEACH

7900
79.09 AC.

7800
237.27 AC

50'-E
37.00 CH

IRRIG.


5.4' E

50' ±

SEE MAP 45 39 4

Application No. 915462
Permit No. 16-15153

1043

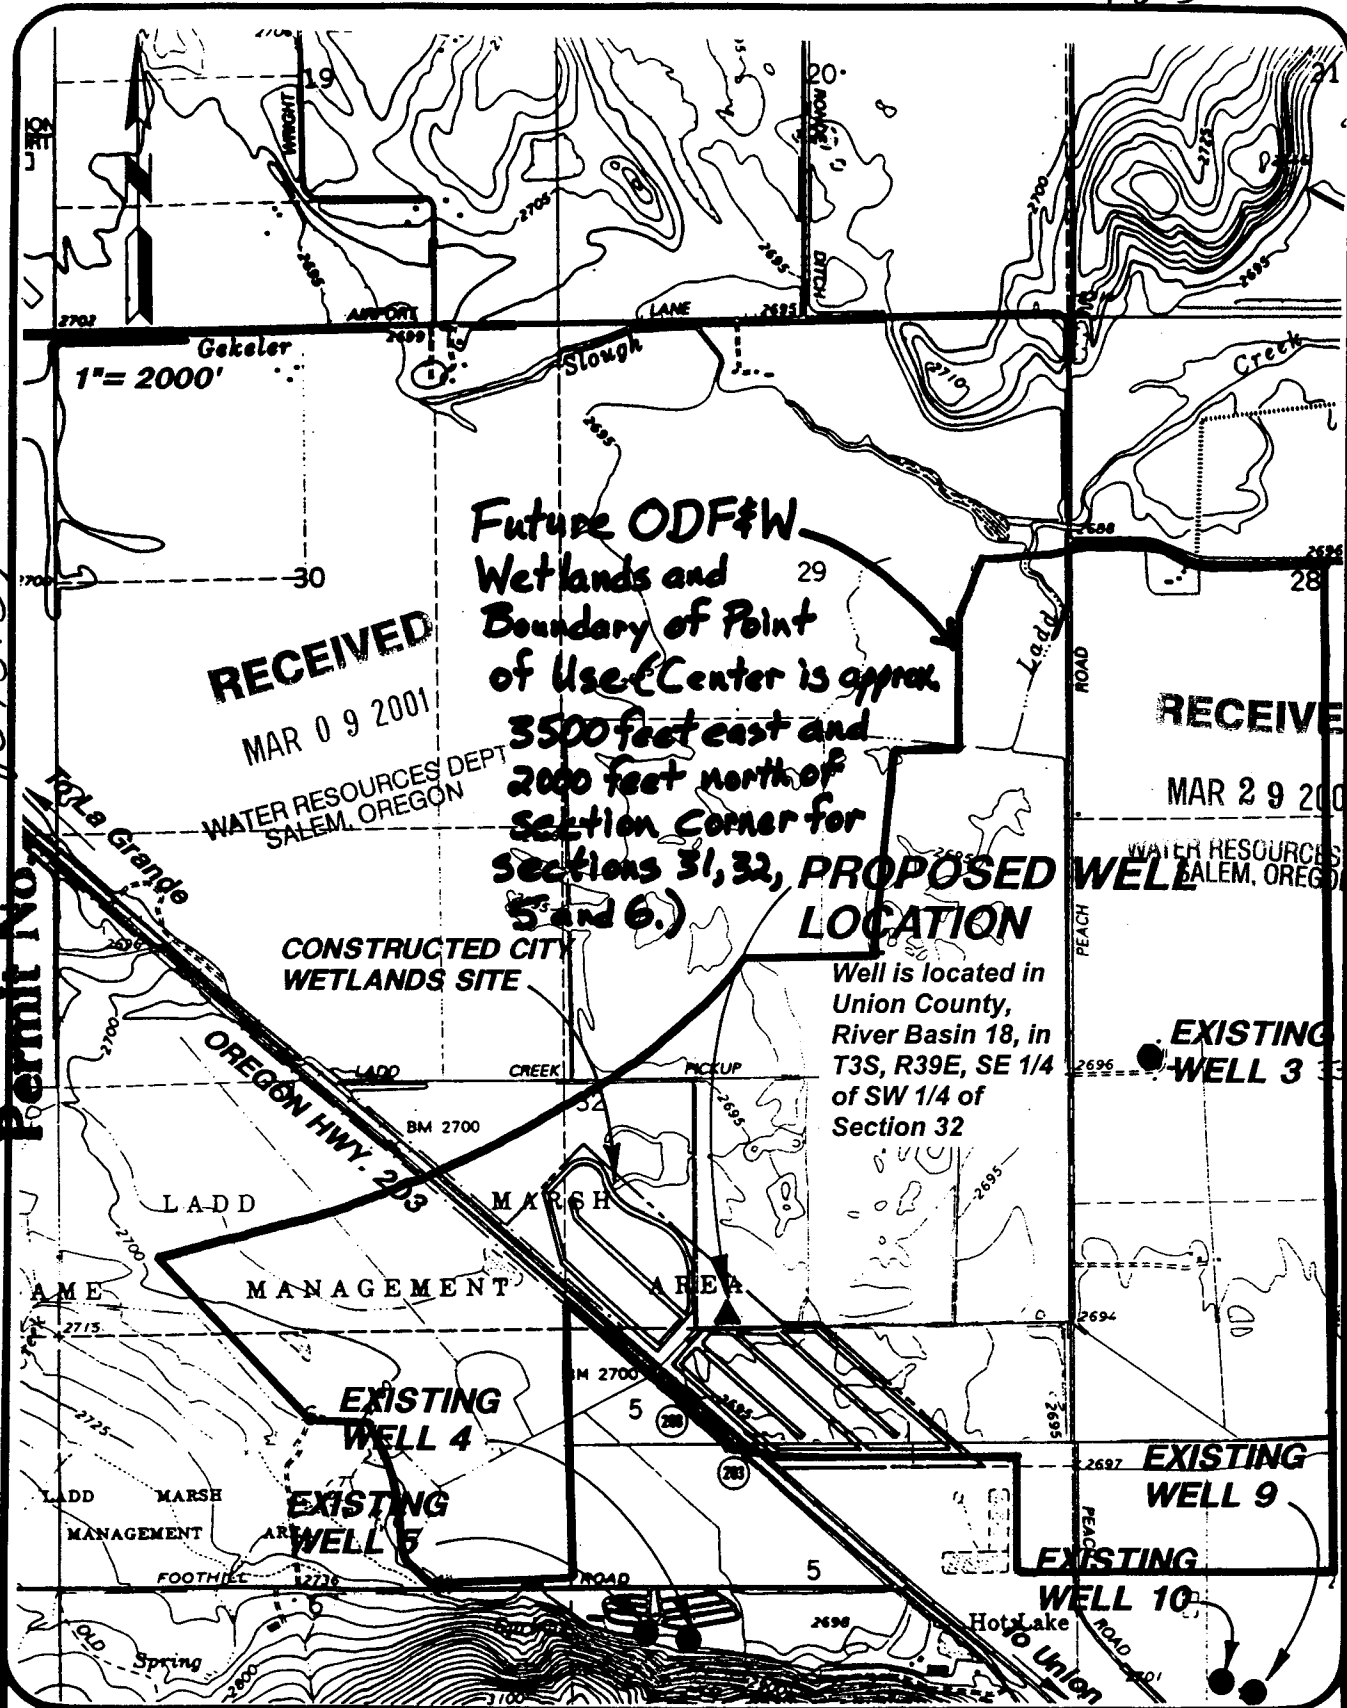

anderson
perry
& associates, inc.

CITY OF LA GRANDE
WASTEWATER SYSTEM IMPROVEMENTS
PHASE I - SCHEDULE A
CITY CONSTRUCTED WETLANDS
VICINITY WELLS

FIGURE
1