BAKER COUNTY

ASSESSMENT PURPOSE ONLY

BAKER COL

T9S R39E SECTION 13A

T9S R40E SECTION 18A

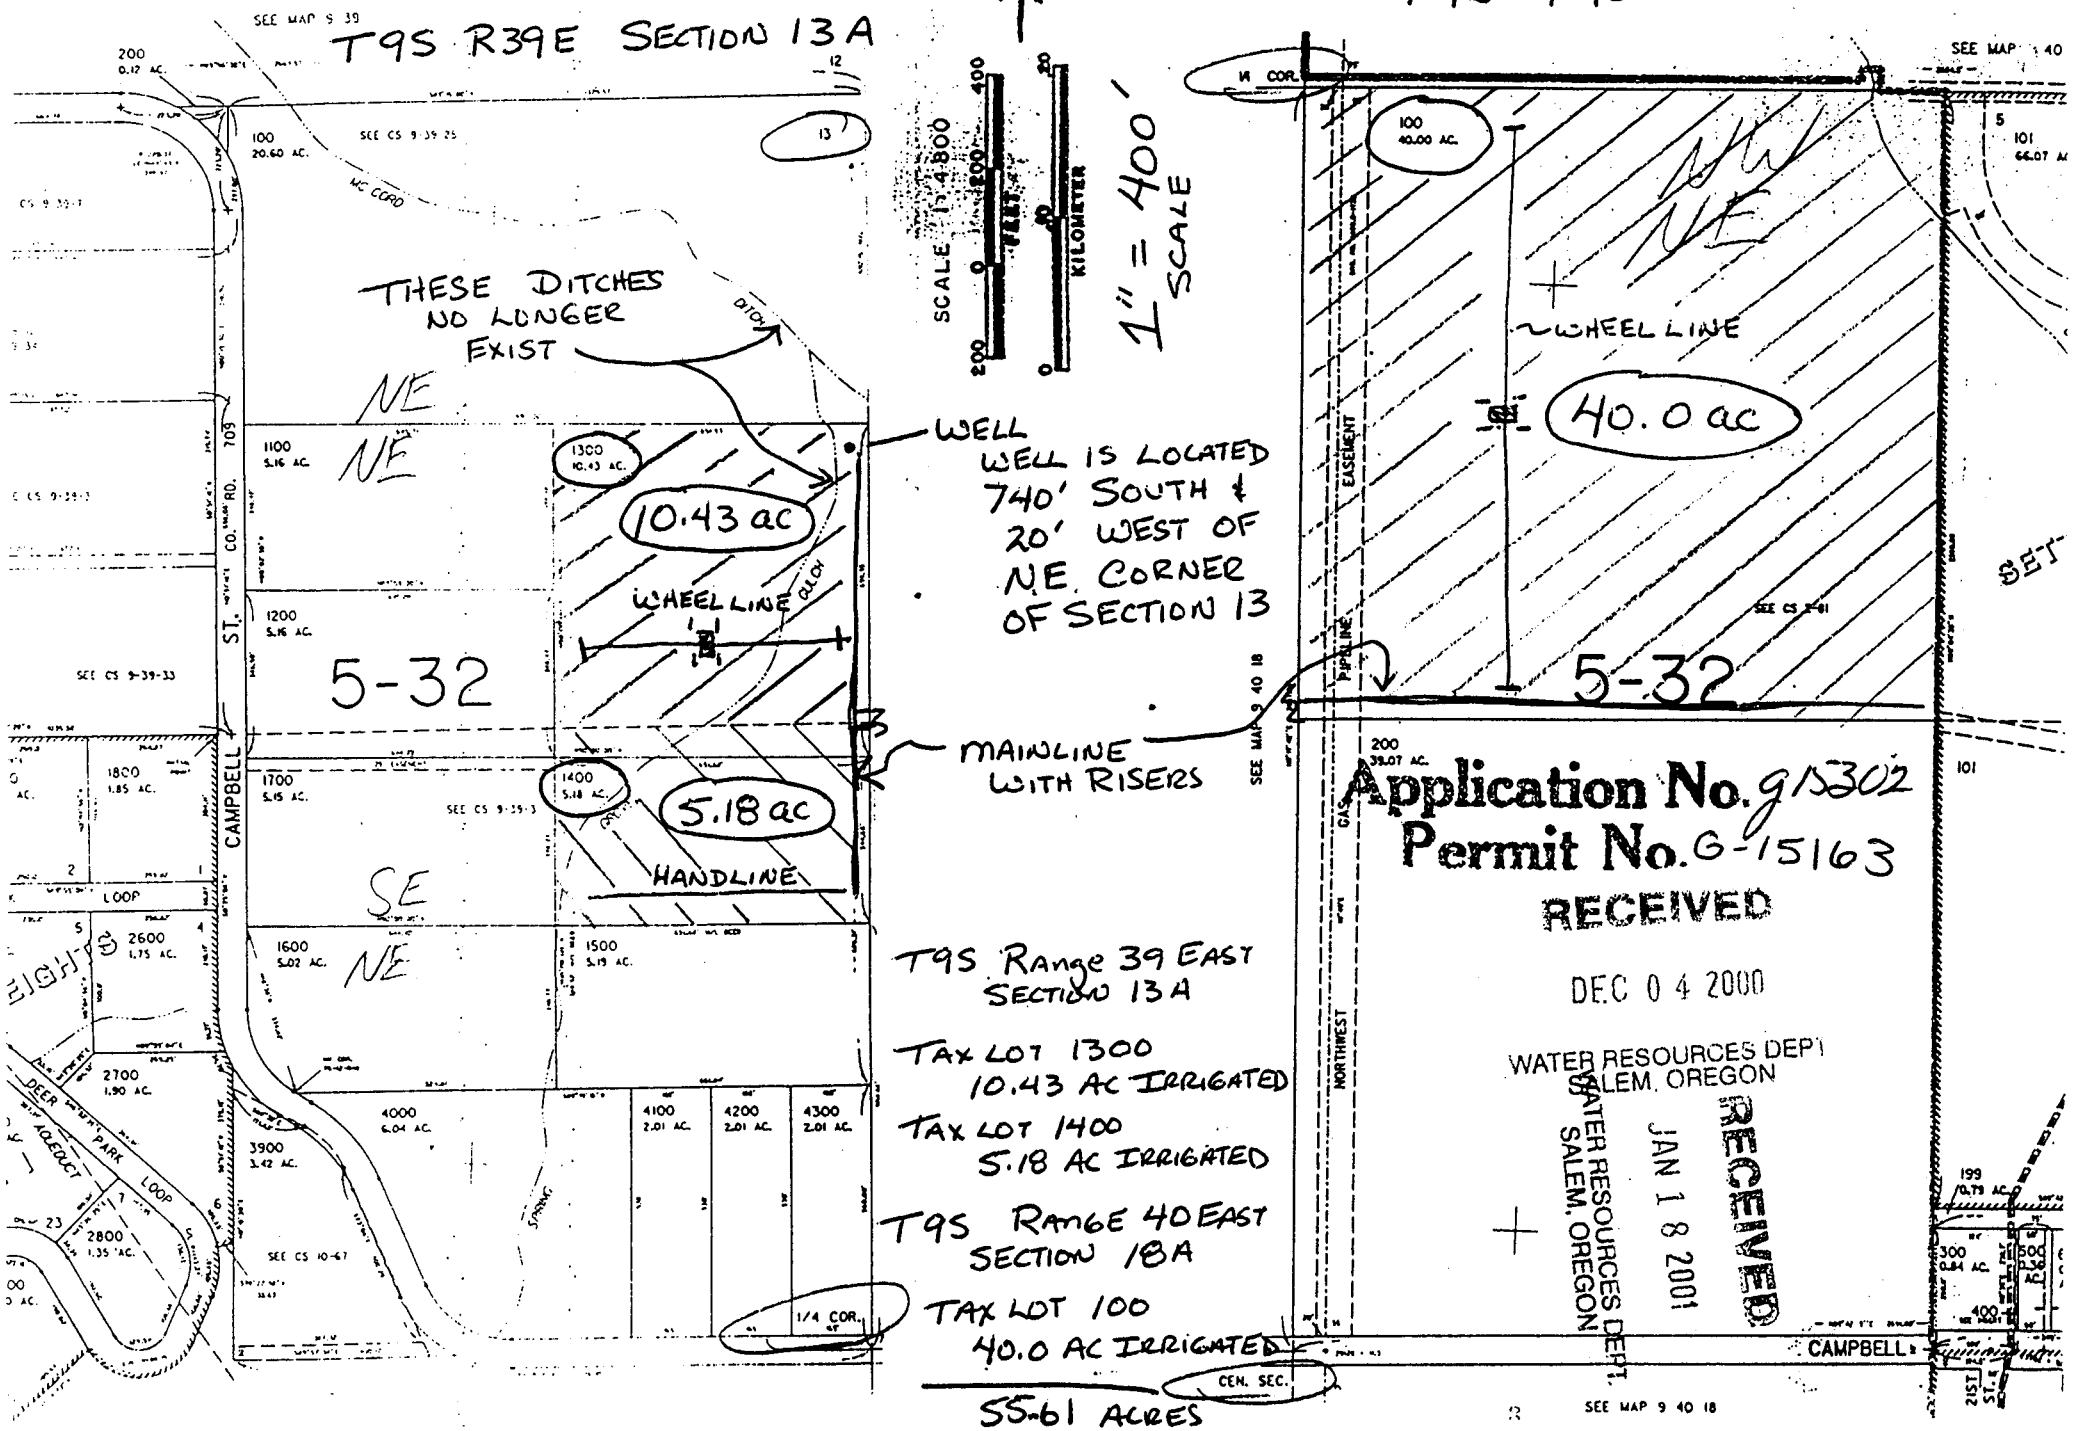


T9S Range 39 EAST
SECTION 13A

TAX LOT 1300
10.43 AC IRRIGATED

TAX LOT 1400
5.18 AC IRRIGATED

T9S RANGE 40 EAST
SECTION 18A

TAX LOT 100
40.0 AC IRRIGATED

55.61 ACRES

**Application No. g15302**
**Permit No. G-15163**

RECEIVED
DEC 04 2000
WATER RESOURCES DEPT
SALEM, OREGON

RECEIVED
JAN 18 2001
WATER RESOURCES DEPT.
SALEM, OREGON