
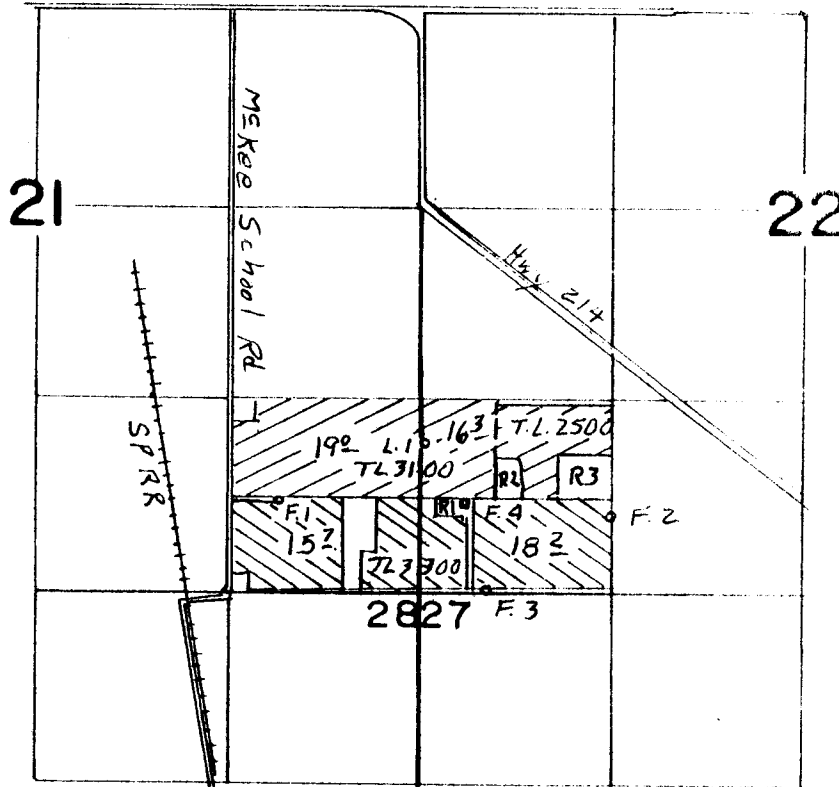


T.5 S. R.1 W. W.M.

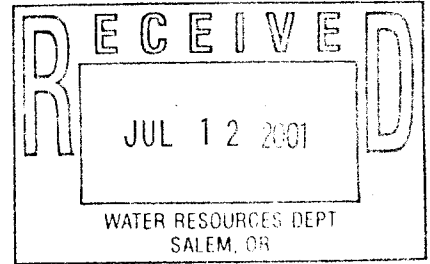

SCALE
4" = 1 Mi.

Part "A" of This application for wells L.1 & F.1, 2 & 3
 Part "B" & "C" Well F.4 For all


LICITE WELL NO. 1 (L.1) LOC.:	1040' N & 20' E FROM SW COR SEC. 22
FESSLER WELL NO. 1 (F.1) LOC.:	630' N & 20' W FROM SW COR SEC. 22
" " " 2 (F.2) "	550' N & 1290' E " " " "
" " " 3 (F.3) "	40' N & 440' E " " " "
" " " 4 (F.4) "	600' N & 260' E " " " "

WATER RIGHT MAP FOR

APPLICATION NO. _____ PERMIT NO. _____ BY _____

FESSLER FAMILY LLC

THIS MAP WAS PREPARED FOR THE PURPOSE OF IDENTIFYING THE LOCATION OF A WATER RIGHT ONLY AND IS NOT INTENDED TO PROVIDE LEGAL DIMENSIONS OR LOCATION OF PROPERTY OWNERSHIP LINES.

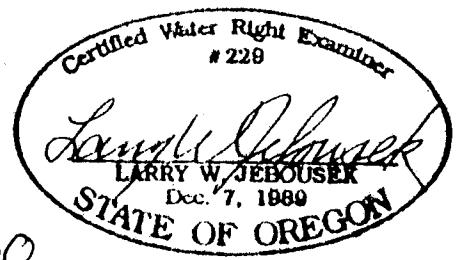

Application No. 6-15560
 Permit No. 6-15172